


MICROFILM

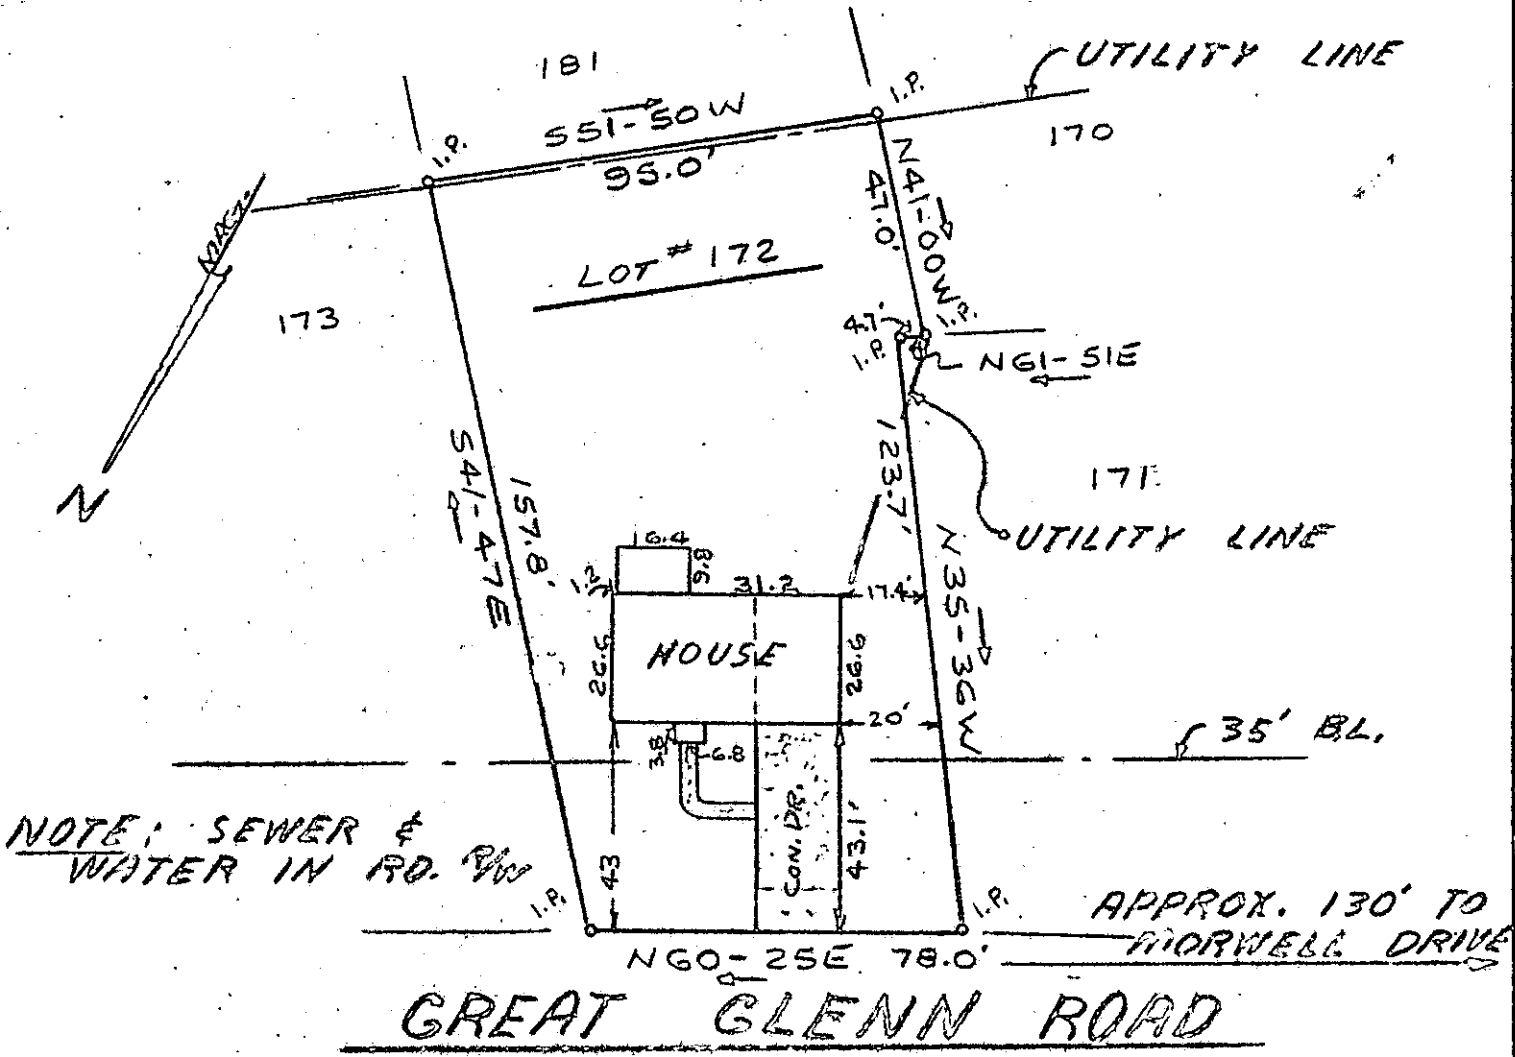


This is to certify that on November 30, 1973, I surveyed the property shown on this plat, know as Part of Lot 172 on plat of Del Norte, Sheet 1, filed in the R.M.C. Office of Greenville County in Plat Book WWW on Page 132 & 33, and that the property lines, walls and buildings are as shown hereon; that the building located on said lot does not encroach or project on adjacent streets or property and that no adjacent walls or buildings encroach or project on said premises, and that no utility lines cross this property except as shown hereon.

James R. Freeland
 James R. Freeland R.L.S. 4781

DEC 6 - 1973
 FILED
 GREENVILLE CO.
 DEC 6 3 33 PM '73
 DANIE S. TANKERSLEY
 R.M.C.
 DBLK BK 58-9-1-130

5C-150 14791

RECORDING FEE
 PAID \$ 1.00

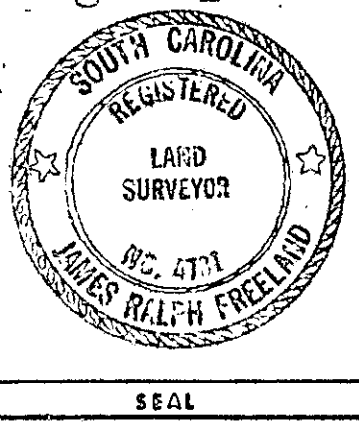

STATE OF SOUTH CAROLINA
 GREENVILLE COUNTY
 DEL NORTE ESTATES-SHEET 1
 PART LOT 172
 PROPERTY OF
 ARTHUR JOSEPH FAZIO &
 HILDA B. FAZIO

FREELAND-JONES & ASSOCIATES
 GREENVILLE, S.C.
 SURVEY T.S.
 DRAWN J.S.
 CHECK J.R.F.
 SCALE 1"=40'
 DATE Nov. 30 1973
 DWO. NO. 72-63