


TOWN PARK OF GREENVILLE, S.C.

HORIZONTAL PROPERTY REGIME
GREENVILLE, SOUTH CAROLINA


FILED
GREENVILLE CO., S.C.
Oct 31 4 30 PM '73
DONNIE S. TANKERSLEY
R.M.C.

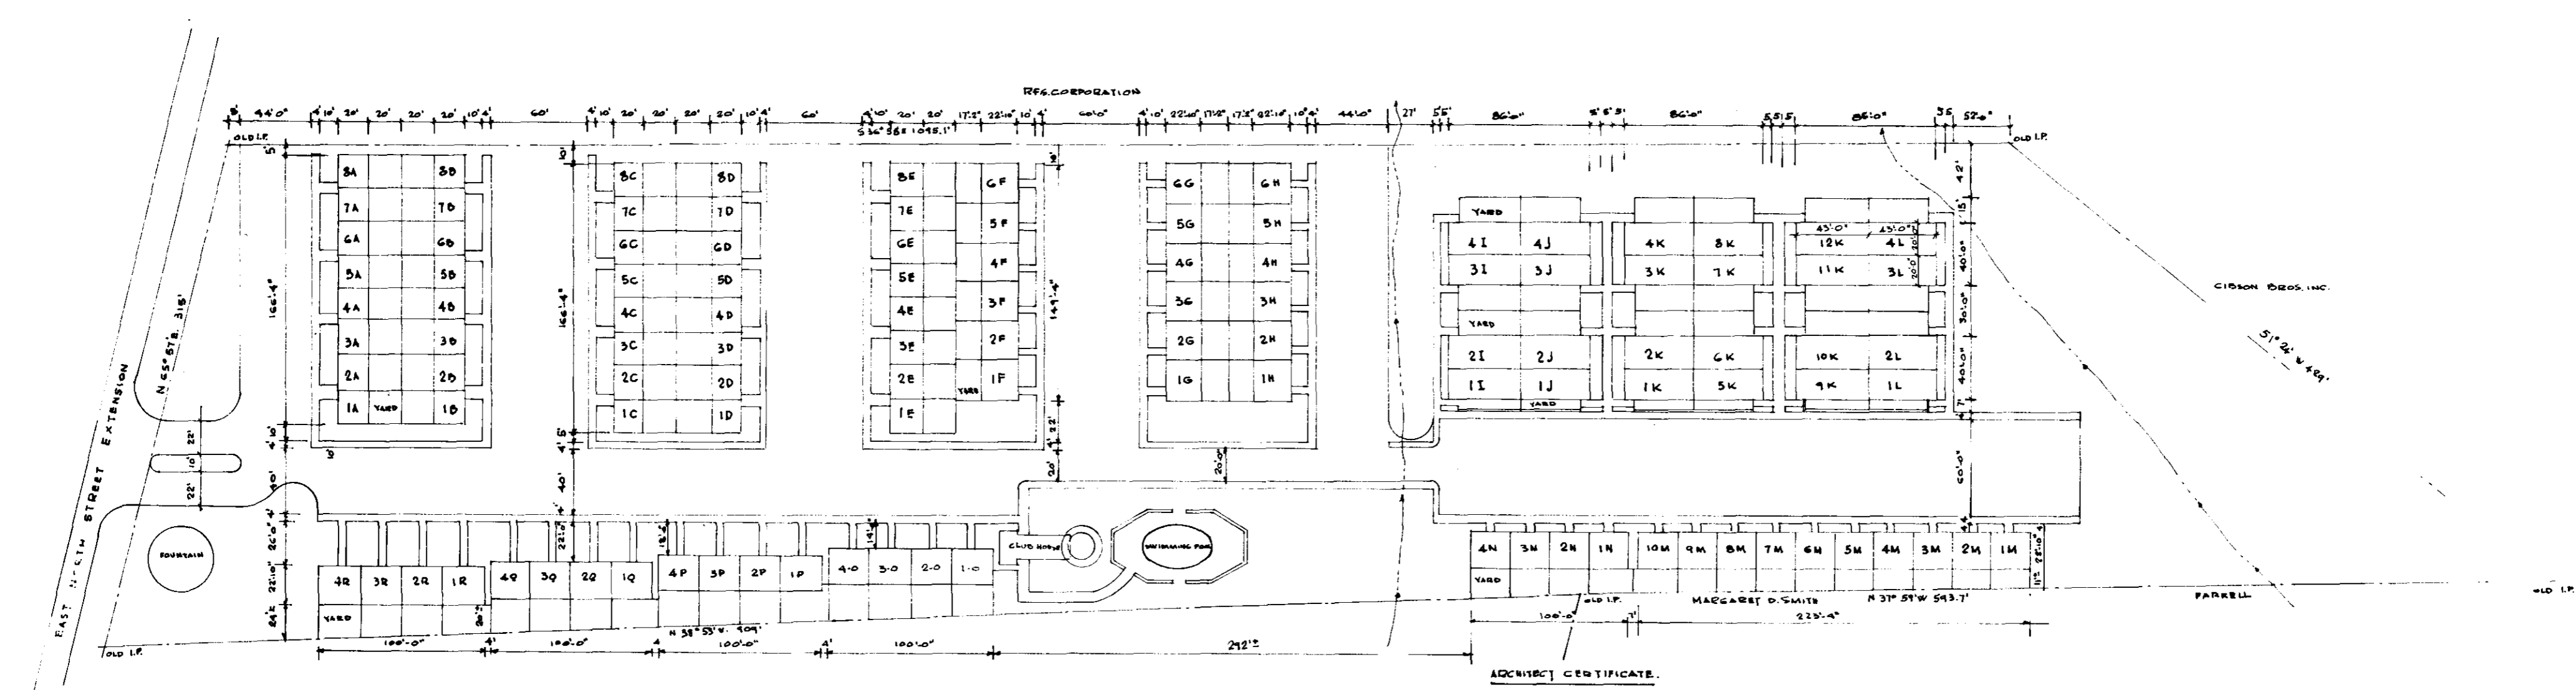

ARCHITECT CERTIFICATE.
I, GUSTAVO MORENO, HEREBY CERTIFY THAT THE ABOVE PLOT PLAN SHOWS THE LAYOUT OF THE BUILDINGS AND OTHER IMPROVEMENTS AND IS TRUE AND IS CORRECT TO THE BEST OF MY KNOWLEDGE. THE SURVEY OF THE LAND WAS MADE BY DALTON & NEVES, ENGINEERS.

DATED THIS
MARCH 12 1973

Gustavo Moreno
GUSTAVO MORENO
REGISTERED ARCHITECT
NO. 714
SOUTH CAROLINA

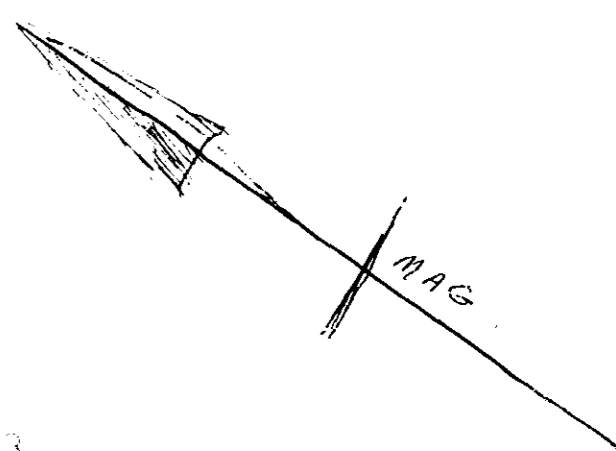

5D-9

#11996 Filed This 31 day of Oct. 1973
and Recorded in Vol. 5D Page 9 at 4:30 PM
Donnie S. Tankersley
Register Mesite Commission Greenville County, S.C.

#11996