



#18725 filed Jan. 25, 1974
 and Recorded in Vol. 5D, Page 23 at 2:59 A.M.
 Donnie D. Tankersley
 Register Meshe Conveyance Green, S.C.

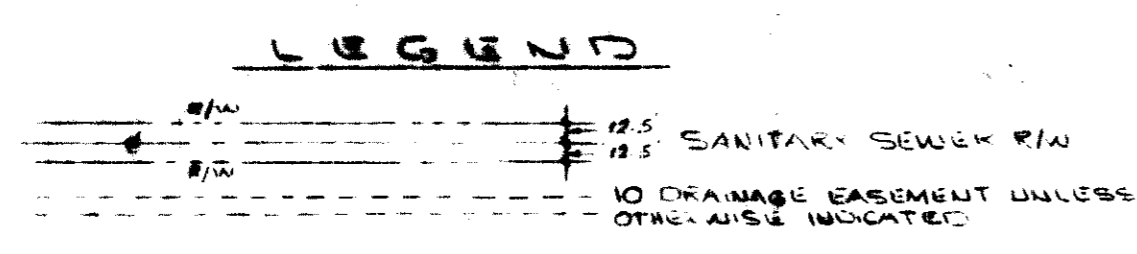

NOTE:
 5' UTILITY & DRAINAGE EASEMENT EACH SIDE OF ALL SIDE & REAR LOT LINES.

REVISED 5D-23
 1/4/74 DATE
 18725
 REVISION: 12/27/73 CHANGE STREET NAME

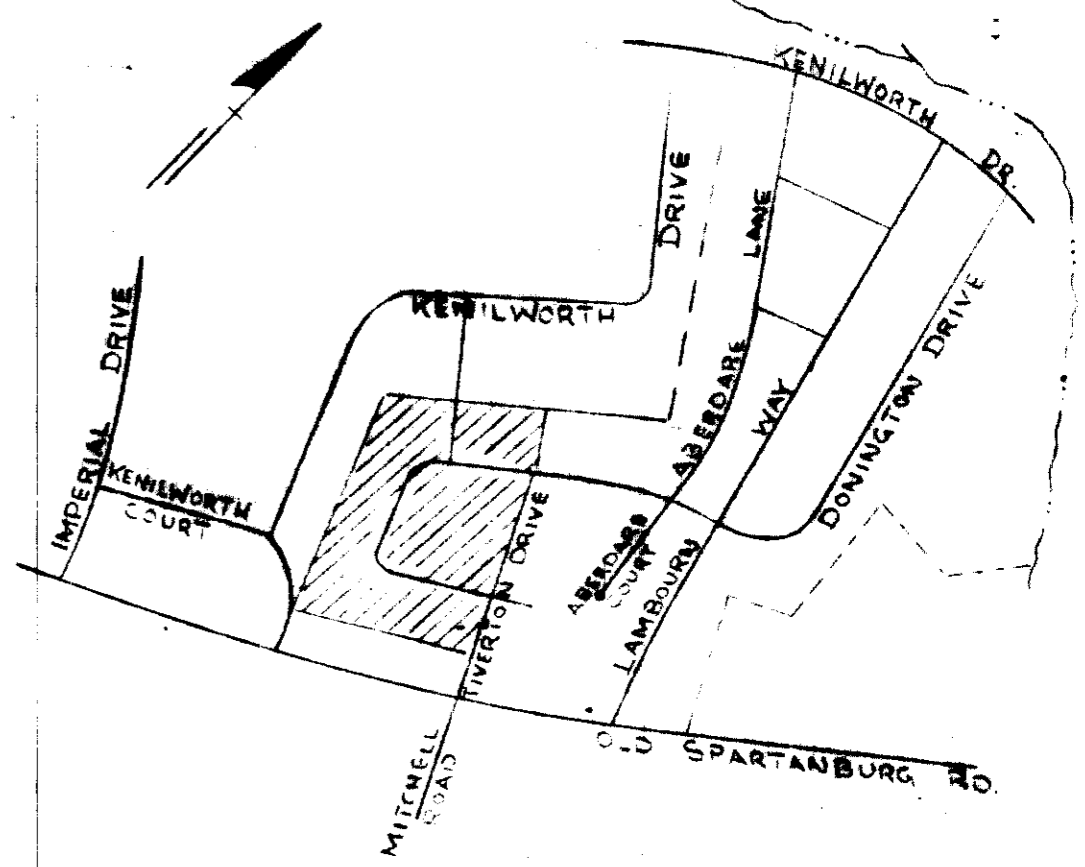

LOCATION MAP

John H. ...

CERTIFICATE OF ACCURACY
 625 001 041 050
 1/3000'
 10/10/73 *John H. ...*
 3616

1/4/74 *J. Blanton Shuman*
 1/25/74 Revised *J. Blanton Shuman*

FILED
 JAN 25 2 59 PM '74
 DONNIE S. TANKERSLEY
 R.M.C.

FILE NUMBER 72-181

-SECTION No TWO-
KINGSGATE

OWNER	PRINCIPAL ENGINEERS & ARCHITECTS	SURVEYOR
NO OF ACRES	12.49	MILES OF NEW ROADS
NO OF LOTS	25	DATE
ERROR OF CLOSURE 1/3000'		

SCALE 1" = 100'

18725