

# FINAL PLAT

## CERTIFICATE OF OWNERSHIP AND DEDICATION

The undersigned hereby acknowledge that I am (we) are the owner(s) of the property shown and described hereon and that I (we) hereby adopt this plan of subdivision with my (our) free consent and that I (we) establish the minimum building restriction lines and hereby dedicate to public use as roads, streets, and easements, forever all areas so shown or indicated on said plat

10 / 30 / 1973  
 Signed *James W. Green*  
 Signed \_\_\_\_\_  
 Signed \_\_\_\_\_  
 Signed \_\_\_\_\_

## CERTIFICATE OF ACCURACY

I, R. W. Dalton, certify that this plat was drawn by me (or drawn under my supervision) (an actual survey made under my supervision) from an actual survey made by me (or deed description recorded in Book \_\_\_\_\_ Page \_\_\_\_\_ etc.) (other) that the error of closure as calculated by latitudes and departures is \_\_\_\_\_ that the boundaries not surveyed are shown as broken lines plotted from information found in Book \_\_\_\_\_ Page \_\_\_\_\_ that this plat was prepared in accordance with the Greenville County Subdivision Regulations as adopted

7/10/75  
 DATE  
 R. W. Dalton  
 LICENSED ENGINEER OR REGISTERED SURVEYOR

S. C. Registration No. 916



**FINAL PLAN APPROVED**  
 GREENVILLE CITY PLANNING & ZONING  
 DATE 7-17-74 BY *J. Clemon Stone*  
 SECRETARY

FILE NUMBER  
**74-147**

REDEVELOPMENT AUTHORITY  
 FOR THE CITY OF GREENVILLE, S. C.

REDEVELOPMENT AUTHORITY  
 FOR THE CITY OF GREENVILLE, S. C.  
 OWNER: DALTON & NEVES, CO.  
 ENGINEERS

NO. OF ACRES: 10.50      MILES OF NEW ROADS: 0  
 NO. OF LOTS: 2      DATE: OCTOBER, 1973  
 REVISED: MARCH, 1974  
 REVISED: JUNE, 1974  
 REVISED: JULY, 1975

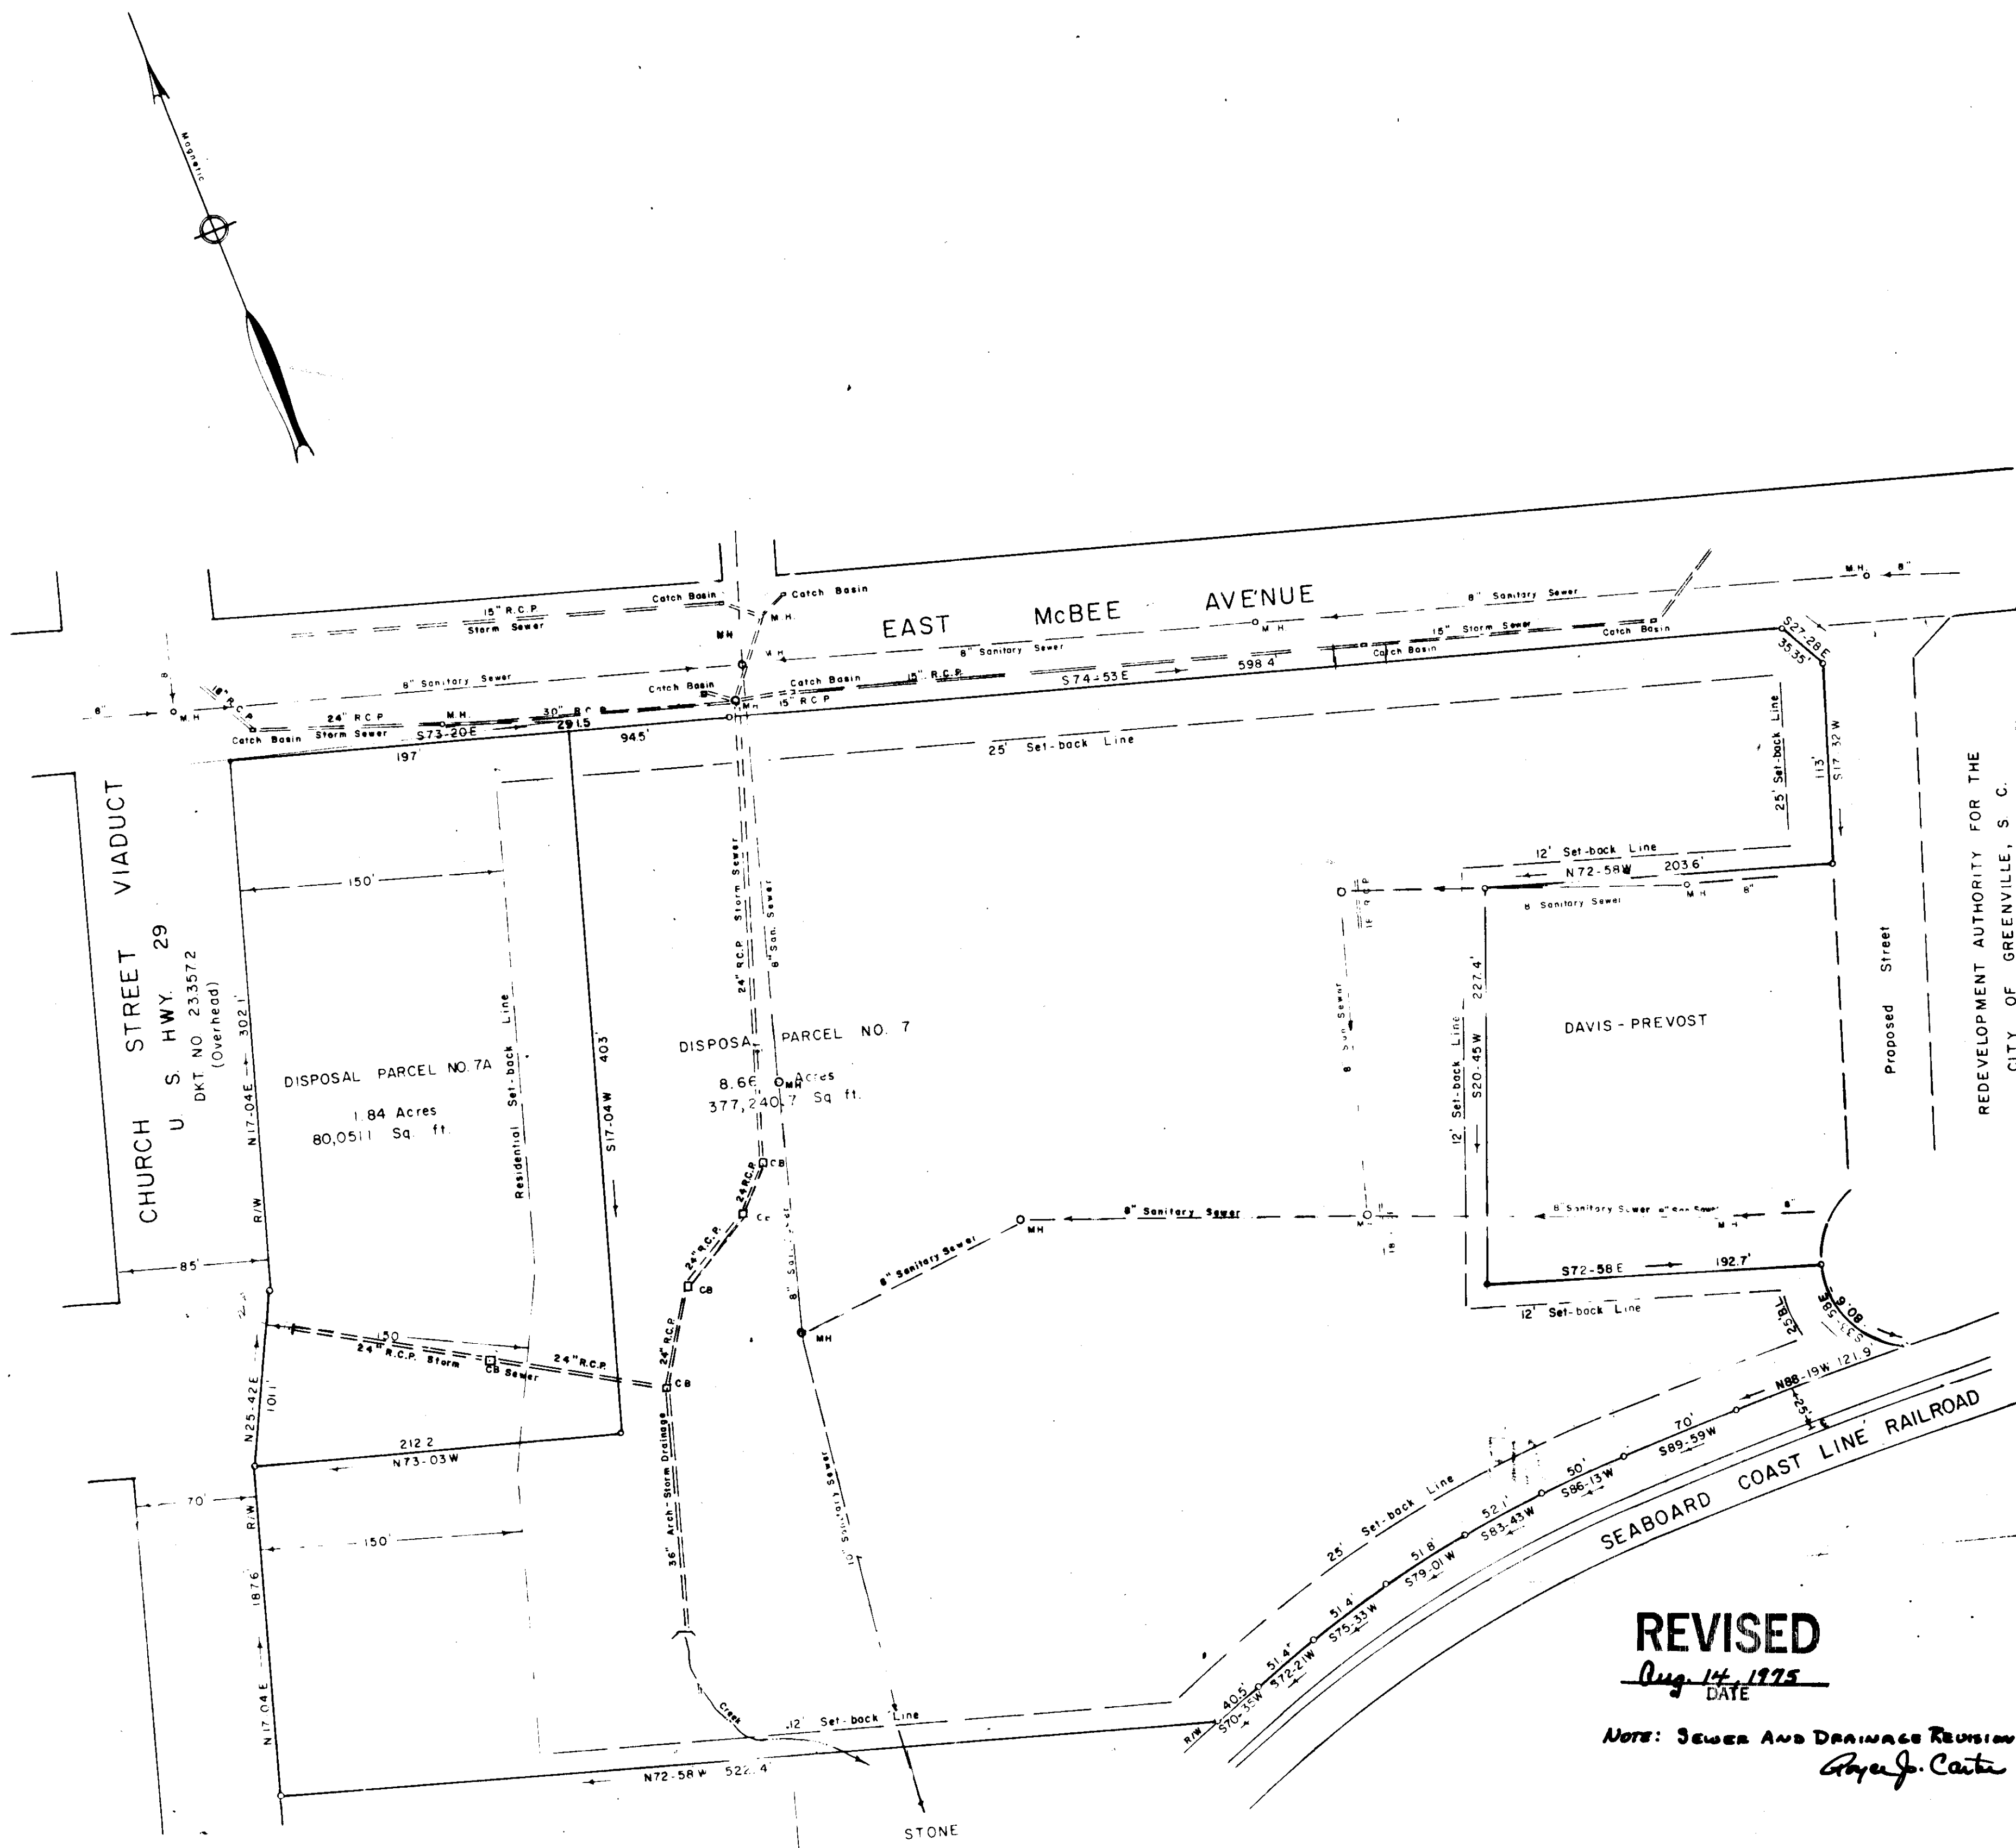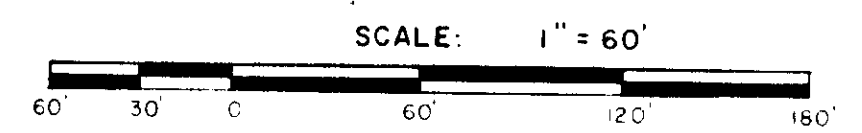

**REVISED**  
 Aug. 14, 1975  
 DATE

NOTE: SEWER AND DRAINAGE REVISION  
*Ray J. Carter*

NOTE:  
 5' DRAINAGE AND UTILITY EASEMENT ALONG  
 SIDE AND REAR PROPERTY LINES

PLAT Filed 18th August 75  
 in Vol. 5D 80 9:22a.

FILED  
 GREENVILLE CO. S. C.  
 AUG 18 9 22 AM '75  
 DONNIE S. TANKERSLEY  
 REC. CLERK

AUG 18 1975 ✓  
 4381  
**5D-80**

MICROFILMED