


MICROFILMED

WILTON ST.
WATER & SEWER IN ST, R/W

RECORDING FEE
PAID \$ 1.00

WILKINSON AVE

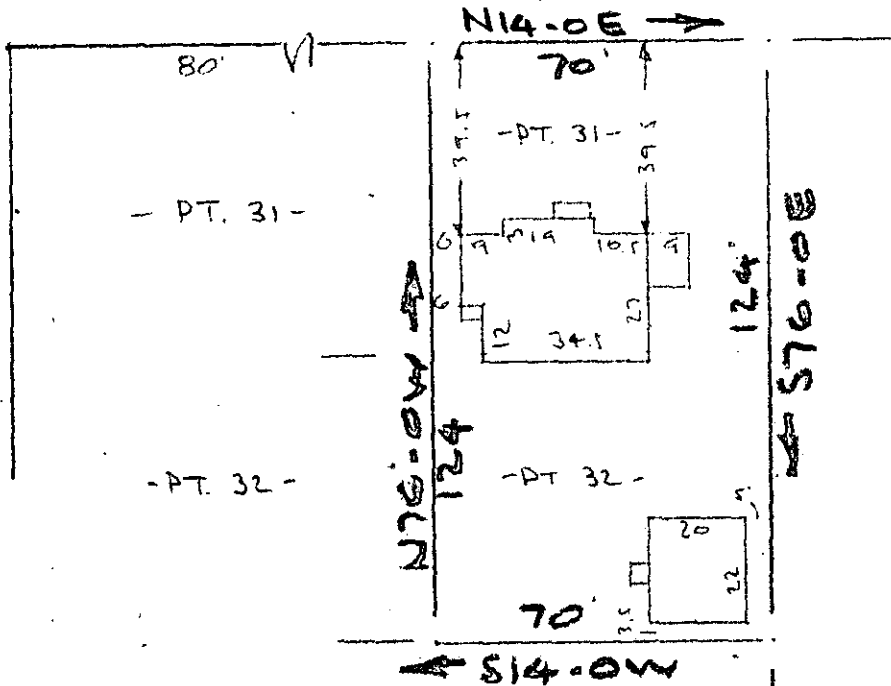

- 30 -

PROPERTY OF
DATSY C. POLIS JR & SANDRA J. POLIS
GREENVILLE, S. C.
SCALE: 1" = 40' 21 DEC 1973

This is to certify that on the 21st day of December 1973, I surveyed the property shown on this plat, being known as part of lot 31 & part of lot 32 on plat of TOWNES ST. PROPERTY and recorded in the REC Office Greenville County, S.C., in Plat Book "B" at Page 5; and that the property lines, walls and buildings are as shown hereon, and that the walls and buildings located on said lot do not encroach or project on adjacent street or property, and that no adjacent walls or buildings encroach or project on said premises, and no power lines cross this property except as shown hereon.

FILED
GREENVILLE CO. S.C.
DEC 31 4 14 PM '73
DONNIE S. TANKERSLEY
R.M.C.

16680

R. B. Bruce
R. B. Bruce, RLS #1952

CAROLINA SURVEYING CO.
112 Manly St.
Greenville, S. C.

5 E - 28

131177

DEC 31 1973