


FILED GREENVILLE CO. S. C. FEB 21 4 13 PH '74 DONNIE S. TANKERSLEY R.M.C.



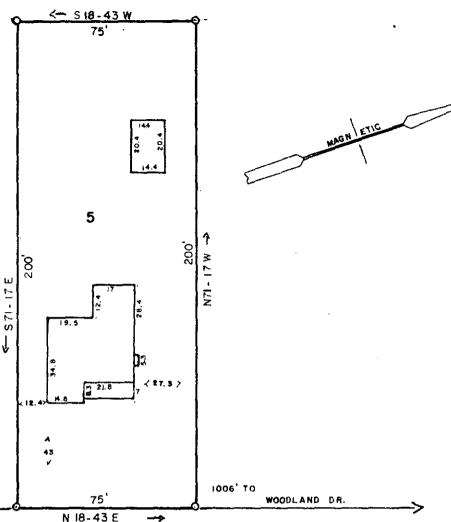



Phio 10 to cortify that on tho 12 day of FEB.

1974 , I surveyed the property shown on this plat, being N.E. Part of TRACT 19, LT5 MOUNTAIN

VIEW ACRES , recorded in Plat Book I

69-70 of the R.M.C. Office for seems le county, S. C., and that the property nes. walls and buildings are as shown hereon; that the buildings located on said lot do not encroach or project on adjacent streets or property; and that no adjacent buildings or walls ancroach or project on said remises, and that no utility lines cross this property.

Reg. Engineer Wo. 1144 S.C.

JOHNNY M. SMITH JOYCE C. SMITH

GREENVILLE SCALE I"= 40' COUNTY, S. C. **20857**

5E-99

FEB 2 1 1974

PAID\$ 1.00

JONES ENGINEERING

SERVICE

1004

E. PERRY

RD.