

B-178

MICROFILMED


FILED
GREENVILLE CO. S. C.

MAR 27 3 30 PM '74

DONNIE S. TANKERSLEY
R.M.C.

W E

JOHNSON

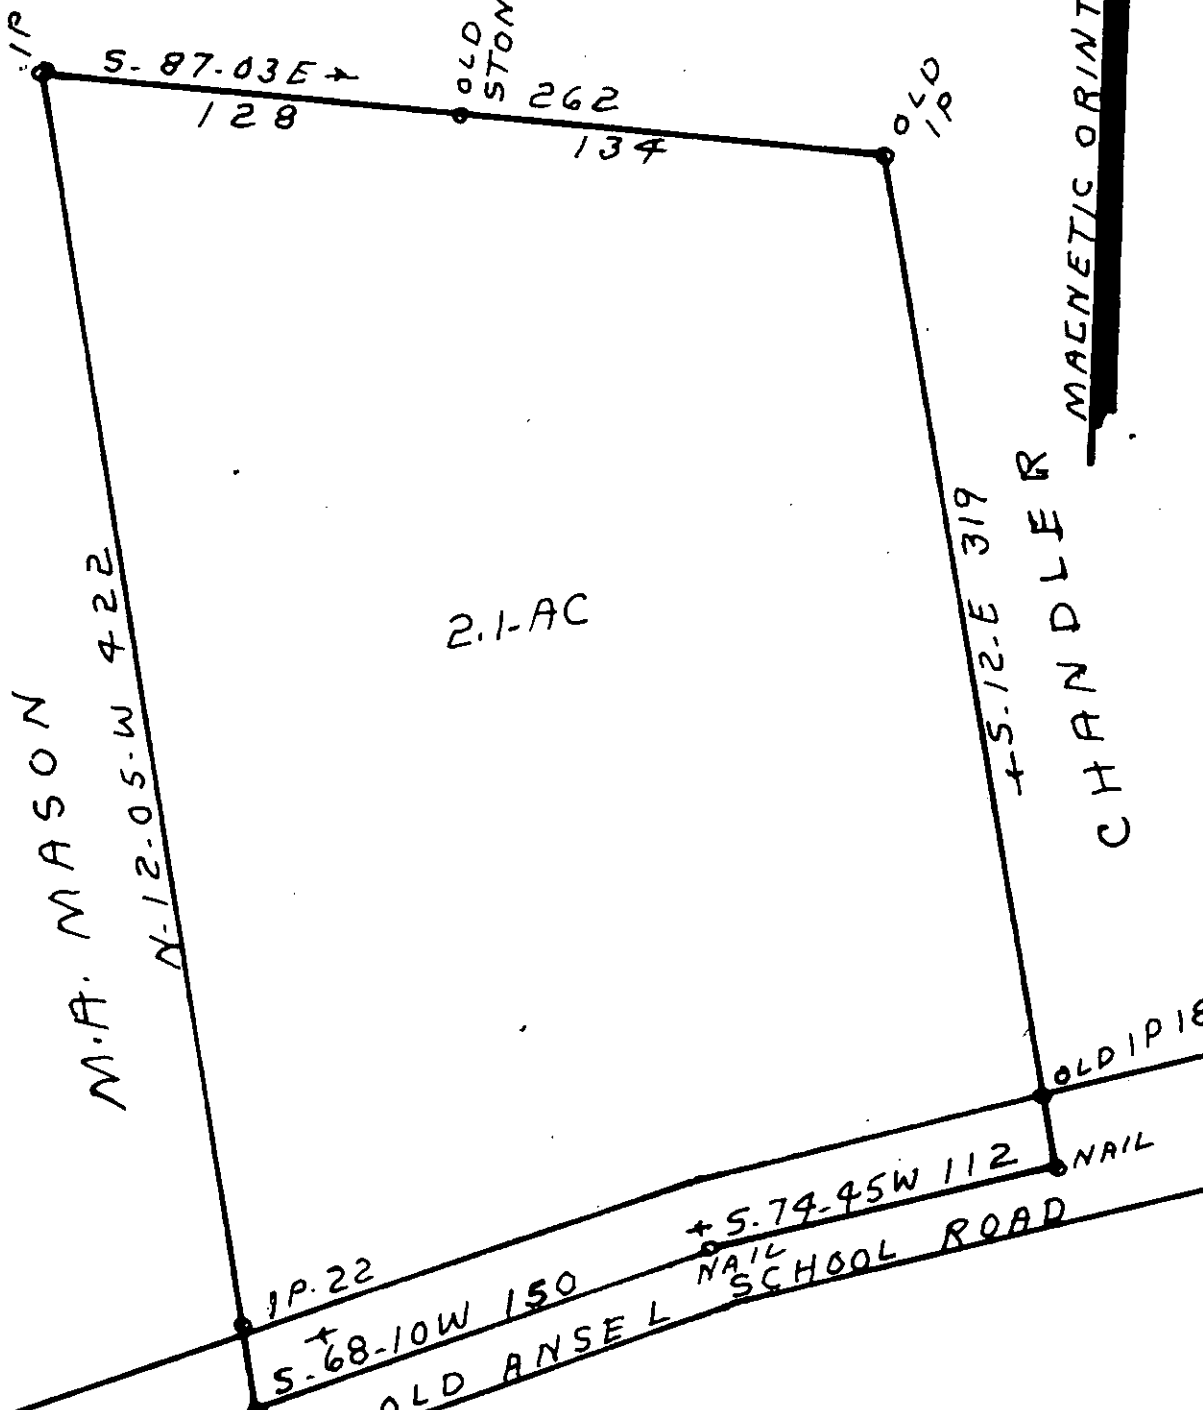

M.A. MASON

2.1-AC

CHANDLER
MAGNETIC ORIENTATION

OLD ANSEL SCHOOL ROAD

NO-701
1000± TO SCHIW

SURVEY FOR
M.A. MASON
GREENVILLE COUNTY SC
2-MI. W. GREER SC
SEE VOL. 234. PG. 115
SCALE - 60' - 3-20-1974
FIELD S.D. ATKINS

MAR 27 1974
5-E 136

W.N. WILLIS ENGRS
SPARTANBURG S.C.

RECORDING FEE
PAID \$ 1.00

24010

S.C. REG-NO-234