


MICROFILMED

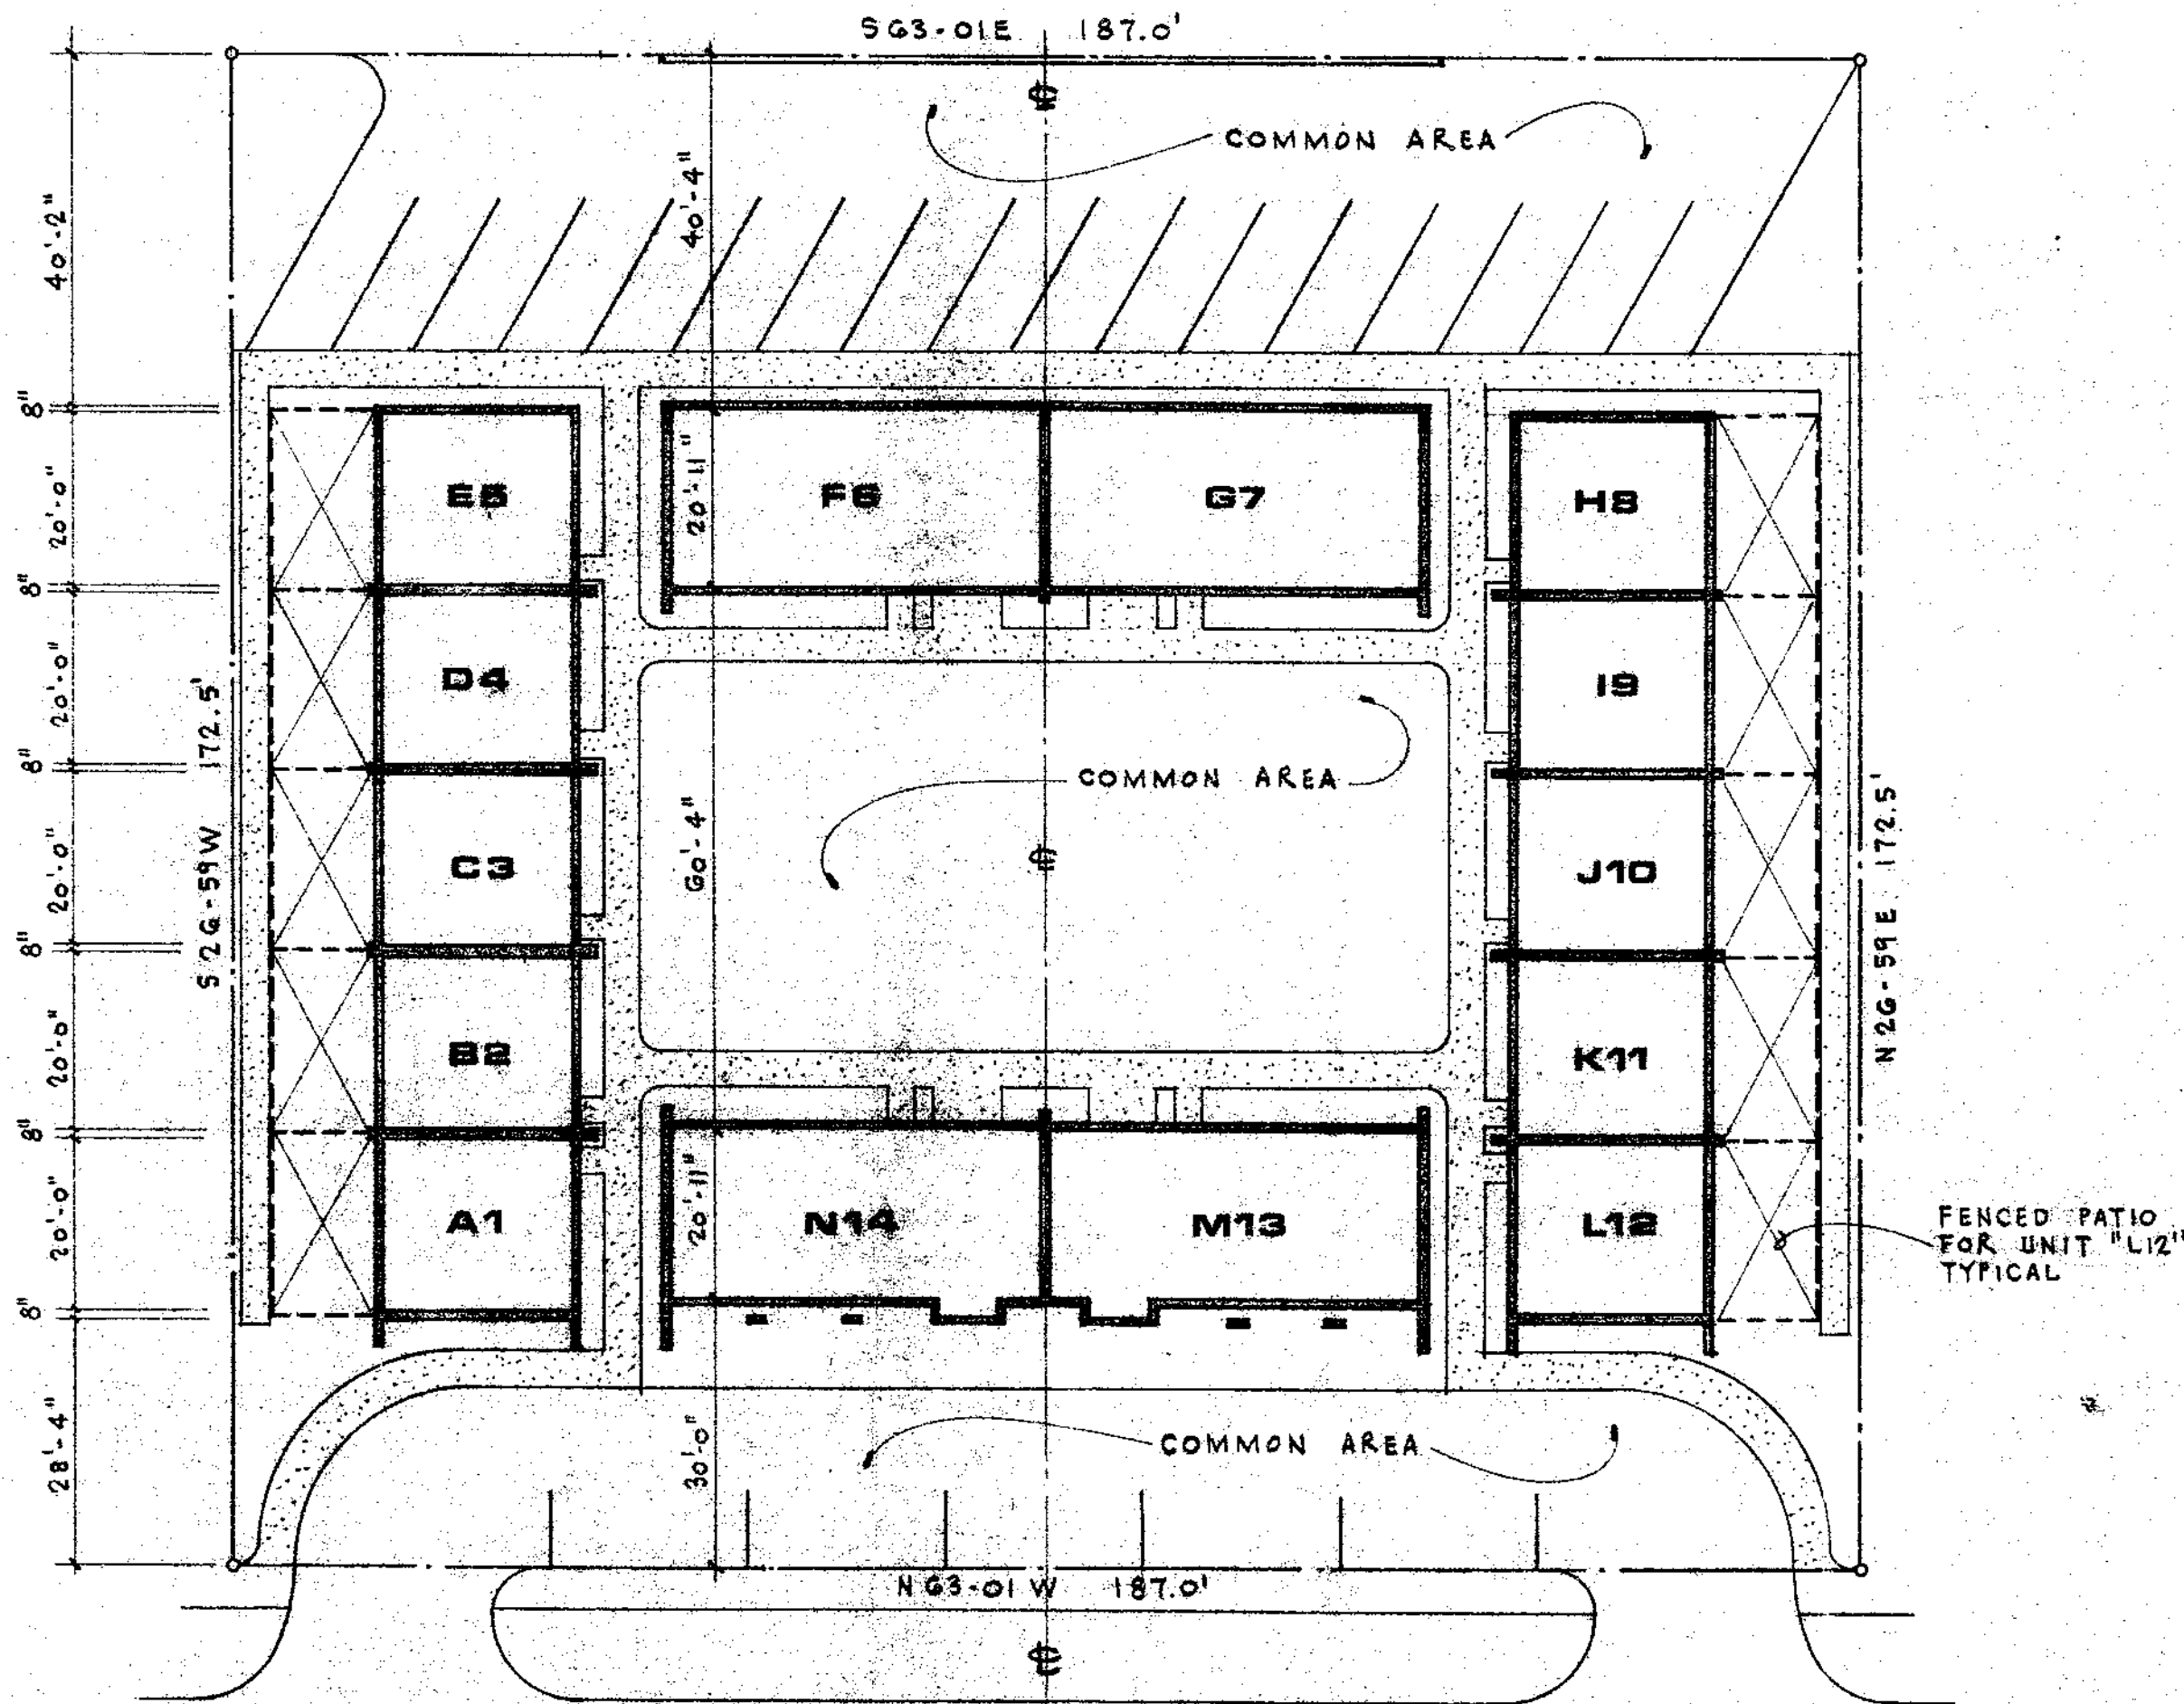


FILED
 GREENVILLE CO. S. C.
 MAY 24 4 23 PM '74
 DONNIE S. TANKERSLEY
 R.M.C.

PLOT PLAN
 1"=20'-0"

ALL DIMENSIONS
 SYMMETRICAL ABOUT
 PROPERTY CENTER LINE

ARCHITECTS CERTIFICATE
 I, JOE W. HILLER, HEREBY CERTIFY
 THAT THIS WRITTEN PLOT PLAN SHOWS THE
 LAYOUT OF THE BUILDINGS AND OTHER
 IMPROVEMENTS AND IS TRUE AND
 CORRECT TO THE BEST OF MY
 KNOWLEDGE.
 DATED THE 23 DAY OF MAY, 1974
 SIGNED *Joe W. Hiller*
 REGISTERED ARCHITECT
 NO. 658, S. C.

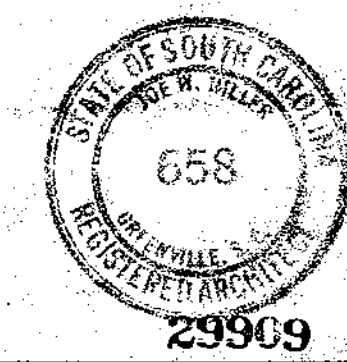

JOE W. HILLER - ARCHITECT
 MEMBER - AMERICAN INSTITUTE OF ARCHITECTS

BOX 5898 - B
 GREENVILLE, S.C.
 29606
 DIAL 232-2162

McPHERSON PARK CONDOMINIUMS
 NO. 10 POINSETT AVE.
 GREENVILLE - S.C.

MAY 24 1974

Fee 3.00

DRAWN BY: RJS
 DATE: 12-12-73
 REVISED:

RECORDING FEE
 PAID \$ 3.50

✓ 5F-52