
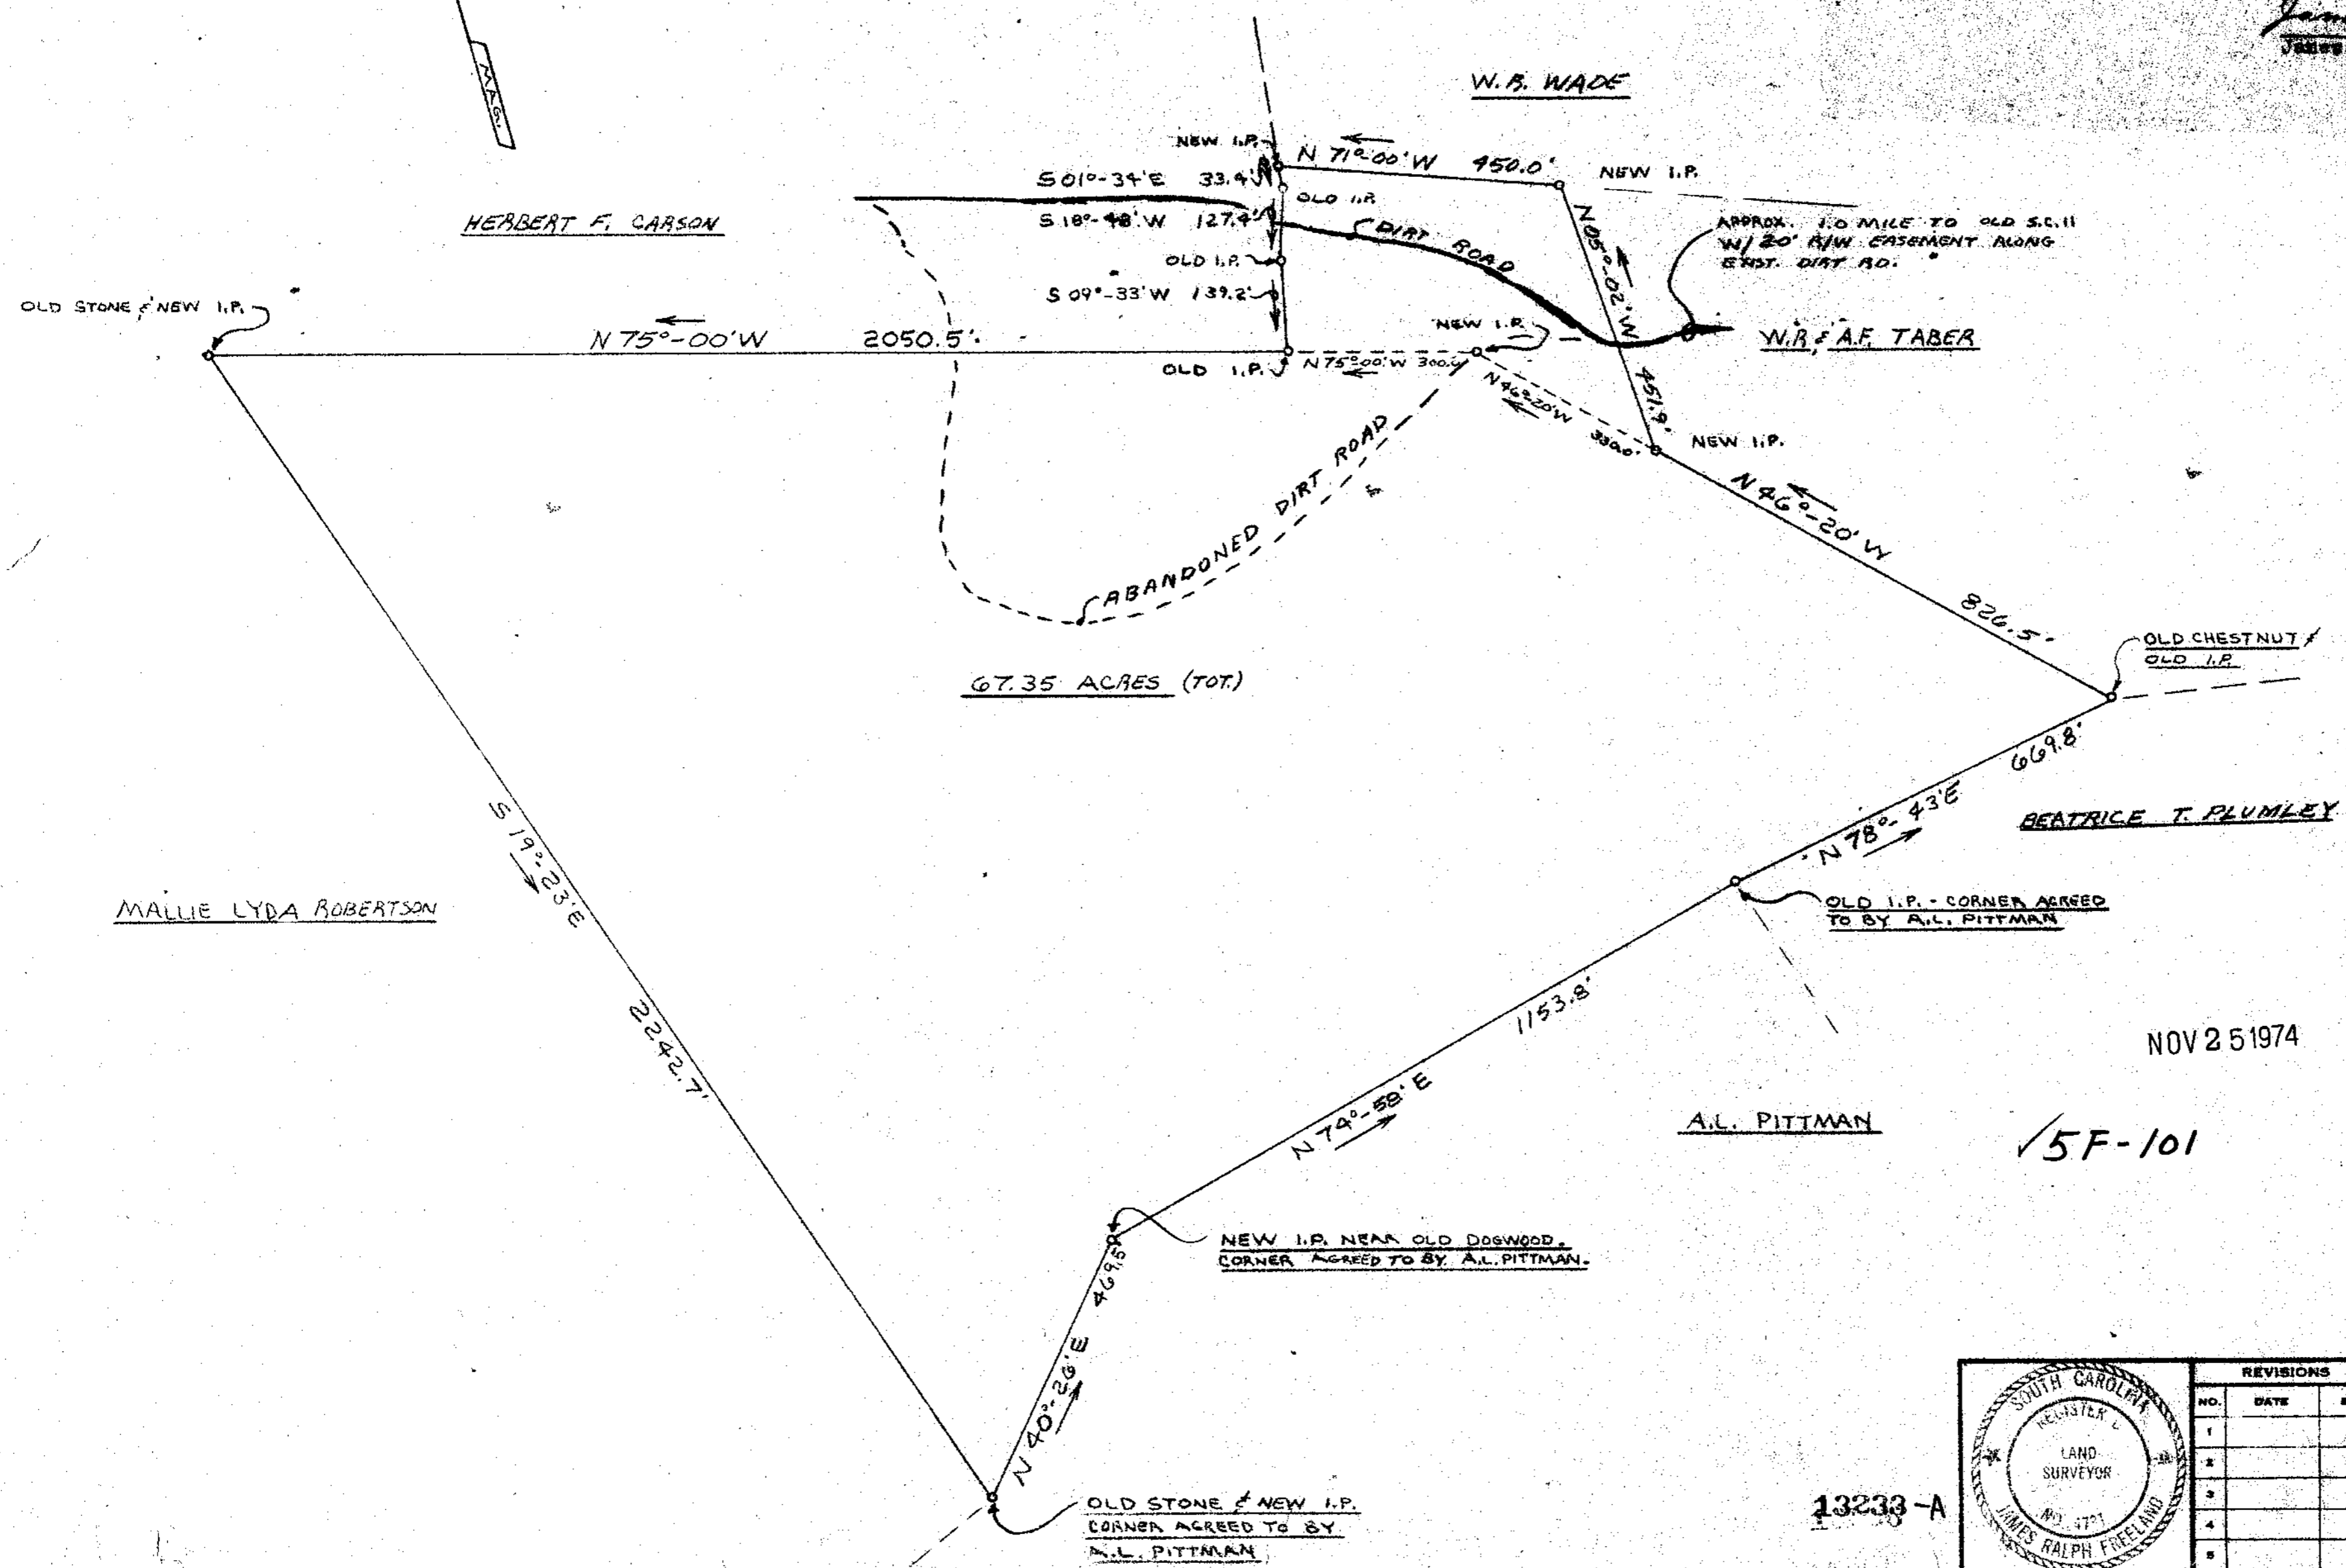


This is to certify that on November 5, 1974, I surveyed the property shown on this plat known as Property of Frances B. and Joseph S. (Jr.) Ridgill, et al, and that the property lines, walls and buildings are as shown hereon, and that no adjacent walls or buildings encroach or project on said premises, and that no utility lines cross this property except as shown hereon.

*James H. Freeland*  
 James H. Freeland S.L.S. #481

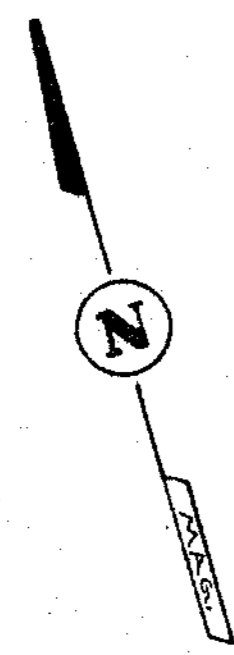

FILED  
 GREENVILLE CO S.C.  
 NOV 25 4 45 PM '74  
 DONALD S. WARENSLEY  
 R.H.C.

NOV 25 1974

15F-101


RECORDING FEE  
 PAID \$ 3.00

STATE OF SOUTH CAROLINA  
 GREENVILLE COUNTY  
 GLASSY MOUNTAIN TOWNSHIP

REVISIONS		
NO.	DATE	BY
1		
2		
3		
4		
5		

PROPERTY OF  
 FRANCES B. & JOSEPH B. (Jr.) RIDGILL et al.  
 FREELAND & ASSOC.  
 GREENVILLE S.C.

DRAWN BY F.L.	SCALE 1" = 200'	MATERIAL
CHK'D NOV 5, 1974	DATE	DRAWING NO.
TRACED	APP'D	73-20

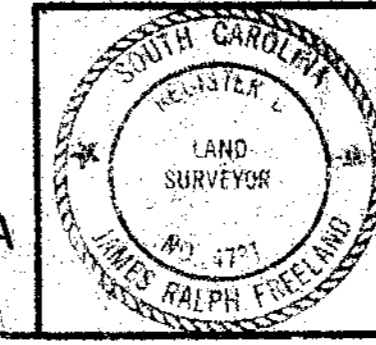

13233-A