
## FLORENCE DRIVE WATER & SOME IN ST. RIW

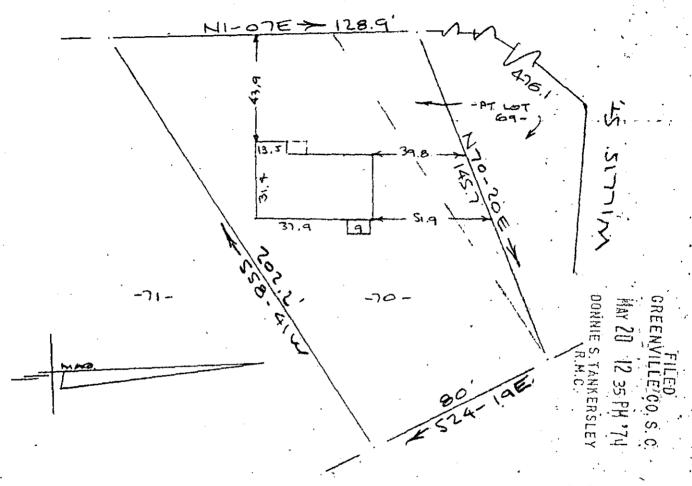

TOMMY E. CLINTON & PEGGY B. CLINTON NEW SIMPSONVILLE, SCALE 12-40

This is to certify that on the 14th day of May 1974, I surveyed the property shown on this plat, being known as lot 70 & part of lot 69 on plat of HUNTERS ACRES and recorded in the RMC Office Greenville County, S.C., in Plat Book "BB" at Page 51; and that the property lines, walls and buildings are as shown hereon, and that the walls and buildings located on said lot do not encroach or project on adjacent street or property, and that no adjacent walls or buildings encroach or project on said premises, and no power lines cross this property except as shown hereon.

5G-59

R. B. Bruce, RLS #1952

RECORDING FEE

CAROLINA SURVEYING CO.
112 Manly St.
Greenville, S. C.

i c