


AUBURN ST.
WATER & SEWER 10 ST. RW

RECORDING FEE
PAID \$ 1.00

SEWAGEE AVE

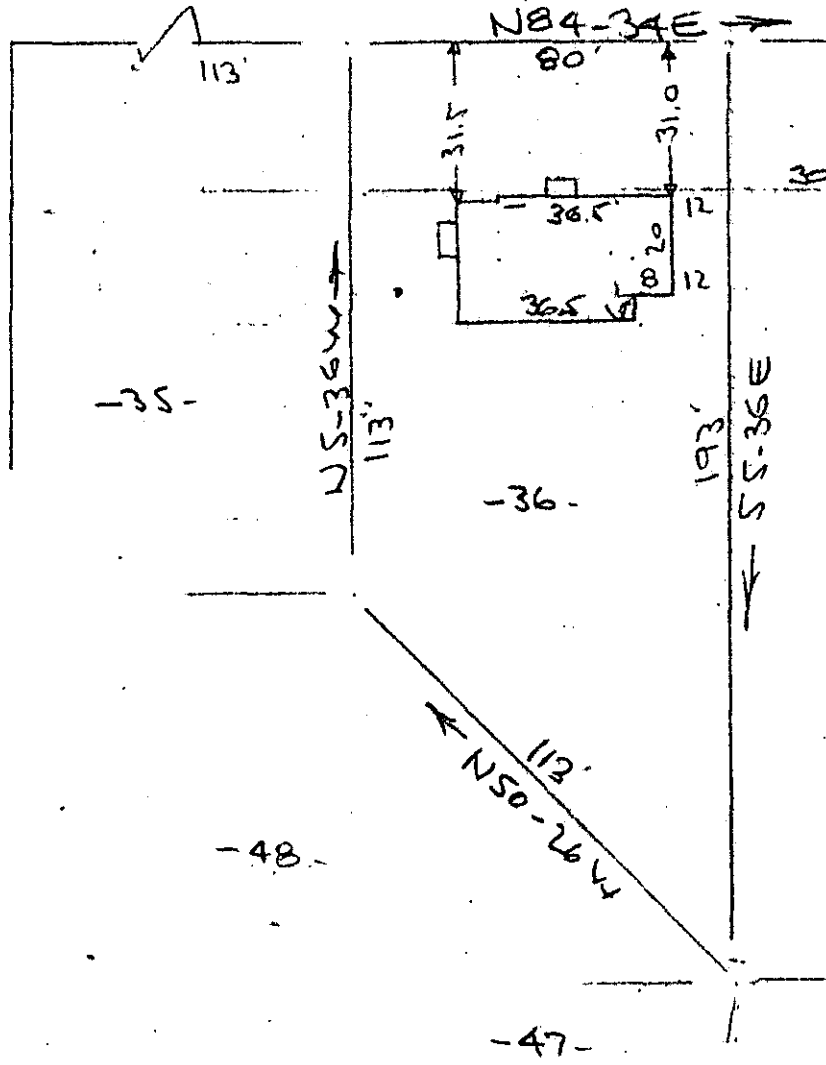

MICROFILMED


FILED
GREENVILLE CO. S.C.
JUN 10 11 26 AM '74
DONNIE S. TANKERSLEY
R.M.C.

PROPERTY OF
THOMAS Y. GILSON & KAREN B. GILSON
NEAR GREENVILLE, S.C.
SCALE: 1" = 40' 17 JUNE 1974

This is to certify that on the 17th day of June 1974, I surveyed the property shown on this plat, being known as lot 36 on a plat of WHITE OAKS and recorded in the RMC office Greenville County, S.C., in Plat Book "P" at page 121; and that the property lines, walls and buildings are as shown hereon, and that the walls and buildings located on said lot do not encroach or project on adjacent street or property, and that no adjacent walls or buildings encroach or project on said premises, and no power lines cross this property except as shown hereon.

R. B. Bruce
R. B. Bruce, RLS# 1952

CAROLINA SURVEYING CO.
112 Manly St.
Greenville, S. C.

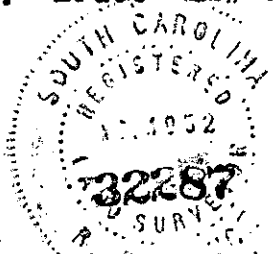

JUN 18 1974

56-82