


BUNCOMBE RD.

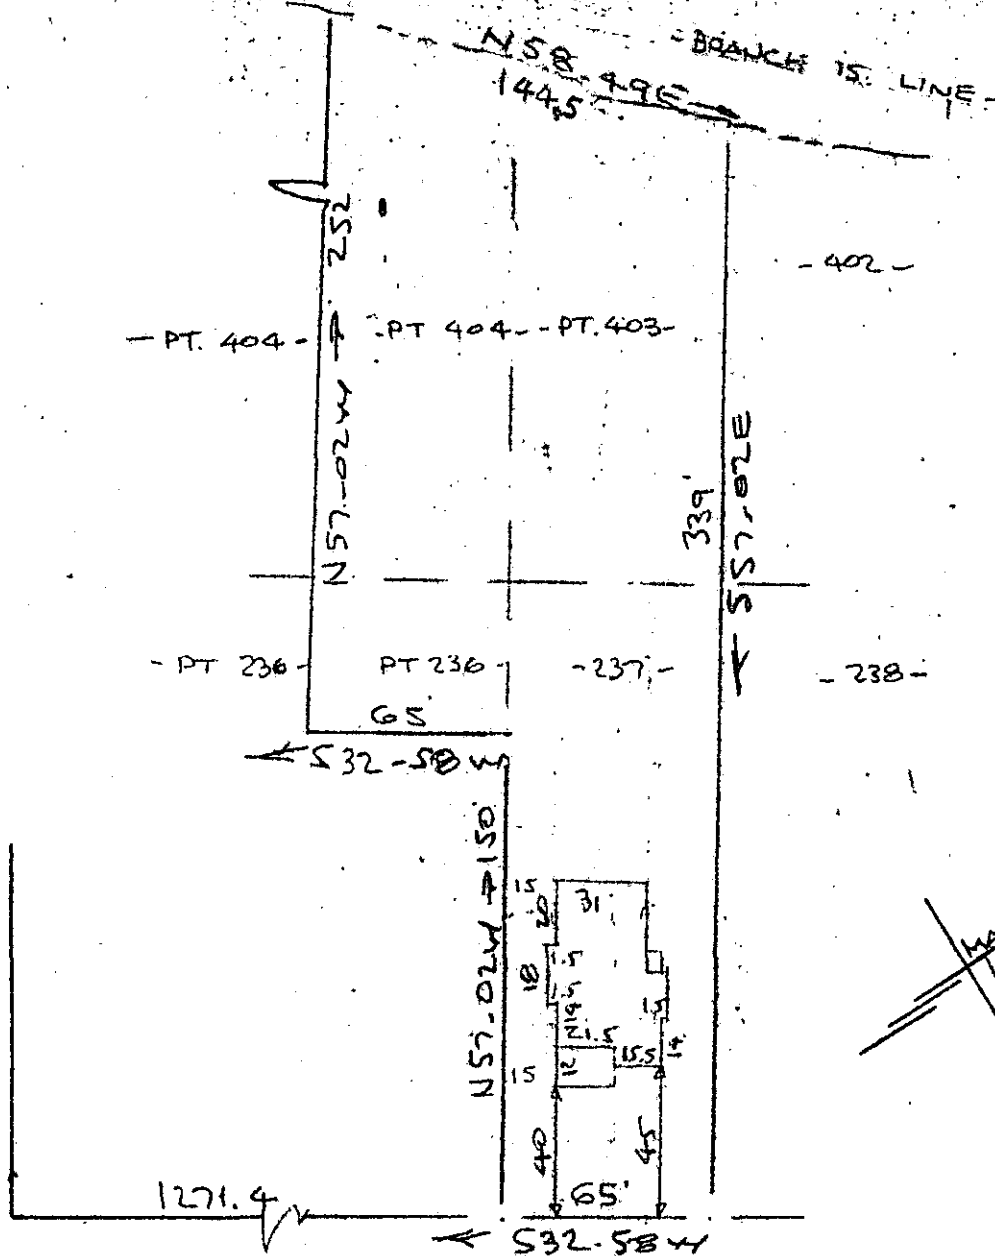

RECORDING FEE PAID \$

MICROFILMED

FILED
 GREENVILLE CO. S. C.
 JUL 3 12 52 PM '74
 DONNIE S. TANKERSLEY
 R.M.C.

NORTH FRANKLIN ROAD
 WATER & SEWER IN ST. RLW

PROPERTY OF
 GERALD W. MEEKS & VALORIE B. MEEKS
 NEAR GREENVILLE, S. C.
 SOLELY BY 26 JUNE 1974

This is to certify that on the 26th day of June 1974, I surveyed the property shown on this plat, being known as part of lots 236 & 404 on a plat of COLONIA CO. and recorded in the RMC Office Greenville County, S.C., in Plat Book "J" at page 4; and that the property lines, walls and buildings are as shown hereon, and that the walls and buildings located on said lot do not encroach or project on adjacent street or property, and that no adjacent walls or buildings encroach or project on said premises, and no power lines cross this property except as shown hereon, also part of 403 & all of lot 237.

R. E. Bruce 1952
 372

✓ 5G-99

CAROLINA SURVEYING CO.
 112 Manly St.
 Greenville, S. C.