


MICROFILMED

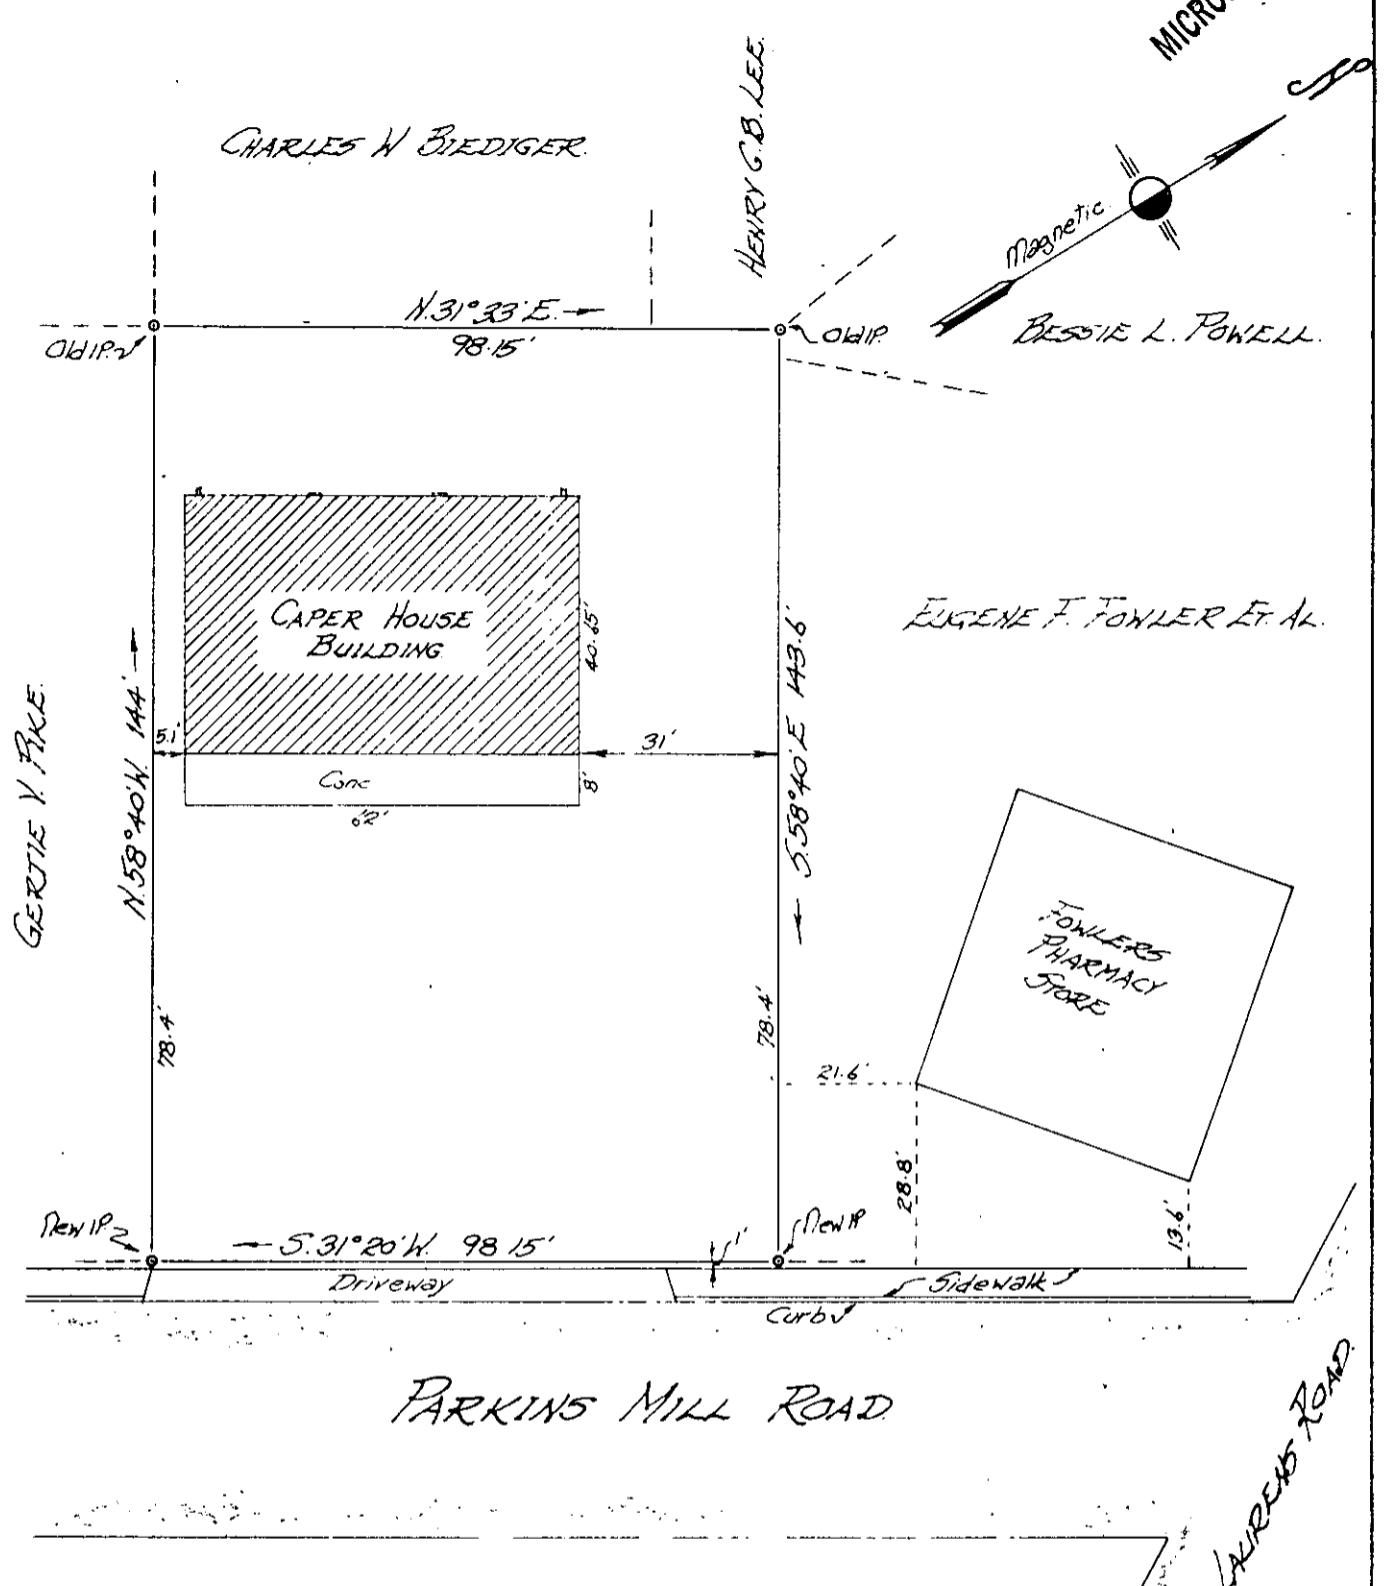

PARKINS MILL ROAD

LAURENS ROAD

5G-103

636

PROPERTY OF

DOT PROPERTIES, INC.

Located in Greenville

GREENVILLE COUNTY,

SOUTH CAROLINA

RECORDING FEE PAID \$ 1.00

FILED GREENVILLE CO. S.C. JUL 8 11 09 AM '74 DONNIE S. TANKERSLEY R.M.C.

Tri-State Surveyors 109 Few Street Greer, S. C. 29651 SCALE: 1" = 30 FEET CERTIFICATE

JUNE 4 1974

This is to certify that on June 4 1974, I surveyed the property shown on this plat, and the same is correct, and that the property lines and building shown do not encroach or project on adjacent streets or property, and that no adjacent buildings or walls encroach or project on said premises.



Signed: John A. Simmons