

MAG.


REFERENCE - HOLLY SPRINGS SECT II.  
PLAT BOOK 4R PAGE 54.

MICROFILM

RECORDING FEE  
PAID \$ 12

BRIDGES ROAD

BROOKBEND ROAD

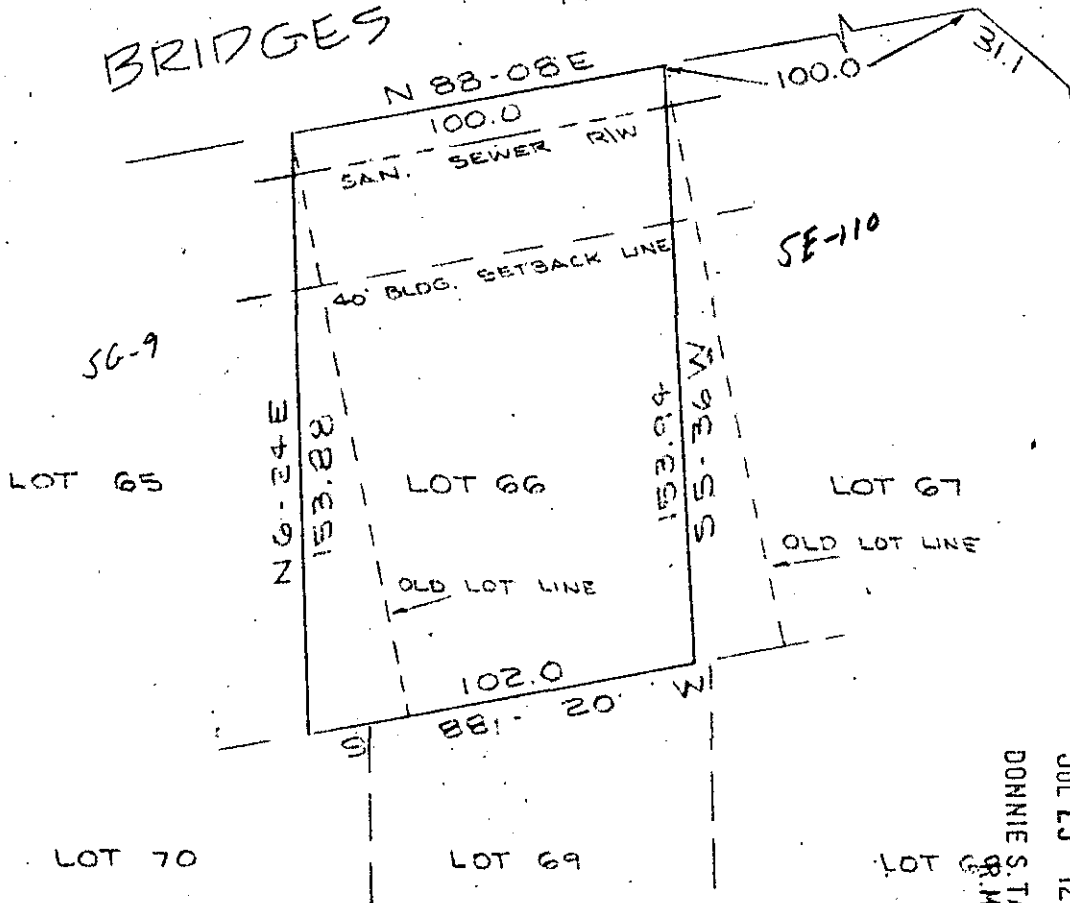

FILED  
GREENVILLE CO. S. C.  
JUL 29 12 22 PM '74  
DONNIE S. TANKERSLEY  
S.M.C.

REVISION OF  
LOT #66  
SECTION II  
HOLLY SPRINGS

MAULDIN, SC.  
SCALE 1"=50'  
13 FEB 1974

PIEDMONT ENGINEERS - ARCHITECTS - PLANNERS  
GREENVILLE, S. C.



✓ 5 G-130

2742