


MICROFILMED

RECORDING FEE PAID \$ 1.02

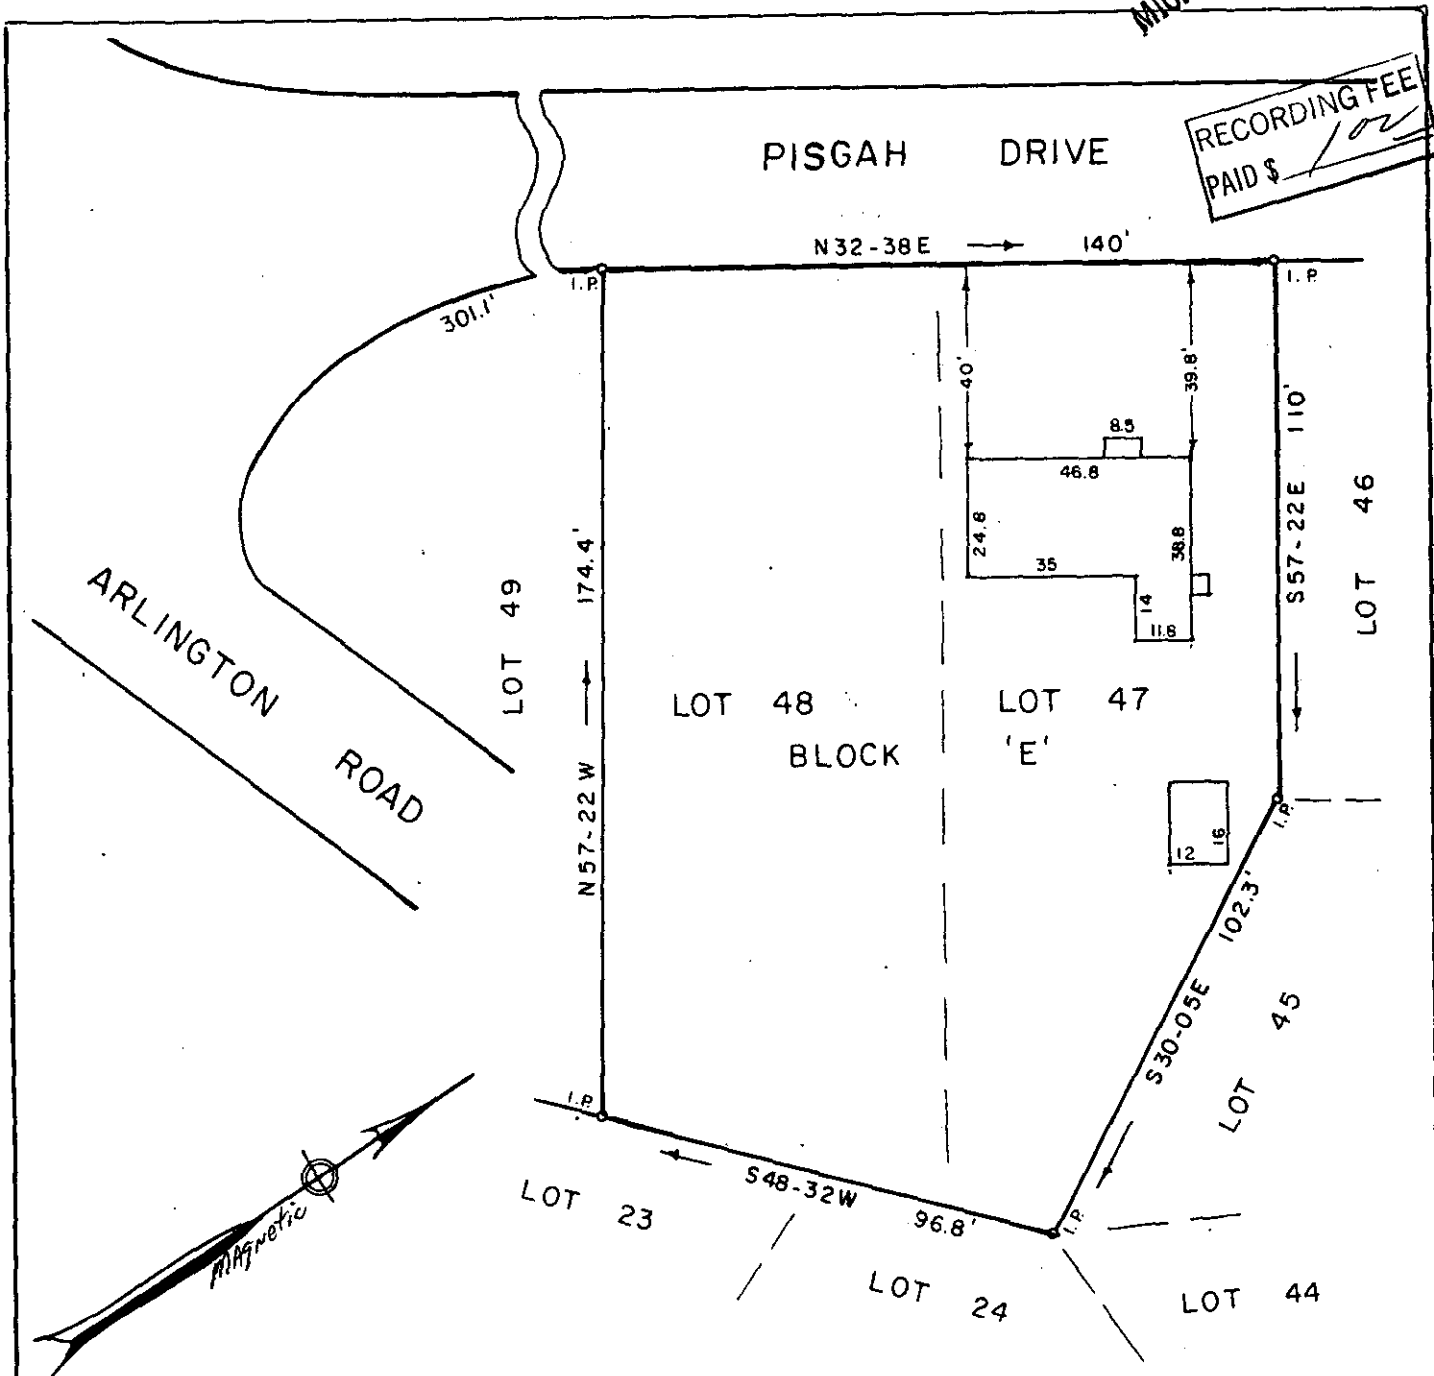


PROPERTY OF
 HENRY CLAYTON IVESTER
 MARILYN J. IVESTER

GREENVILLE CO., S. C.

Scale 1" = 40' August, 1974

FILED
 GREENVILLE CO. S. C.
 AUG 19 12 17 PM '74
 DONNIE S. TANKERSLEY
 R. M. C.

This is to certify that on the 13th day of August, 1974, We surveyed the property shown on this plat; being known as Lots 47 and 48, Block E on plat of Paris Heights, Recorded in Plat Book Y page 65, Office of R. M. C. Greenville Co., S. C.; and that the property lines, walls and buildings are as shown hereon; that the buildings located on said lot do not encroach or project on adjacent streets or property; and that no adjacent buildings or walls encroach or project on said premises.

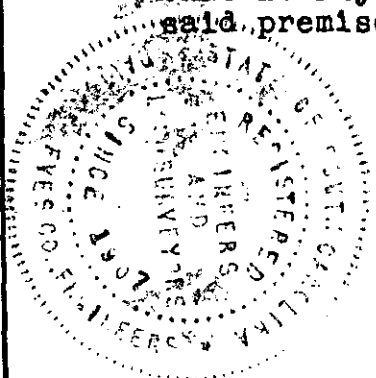

R. W. Dalton
 Dalton & Neves Co., Engineers.
 Hanley Street
 Greenville S.C.

V-5 G-153

4780