


MICROFILMED

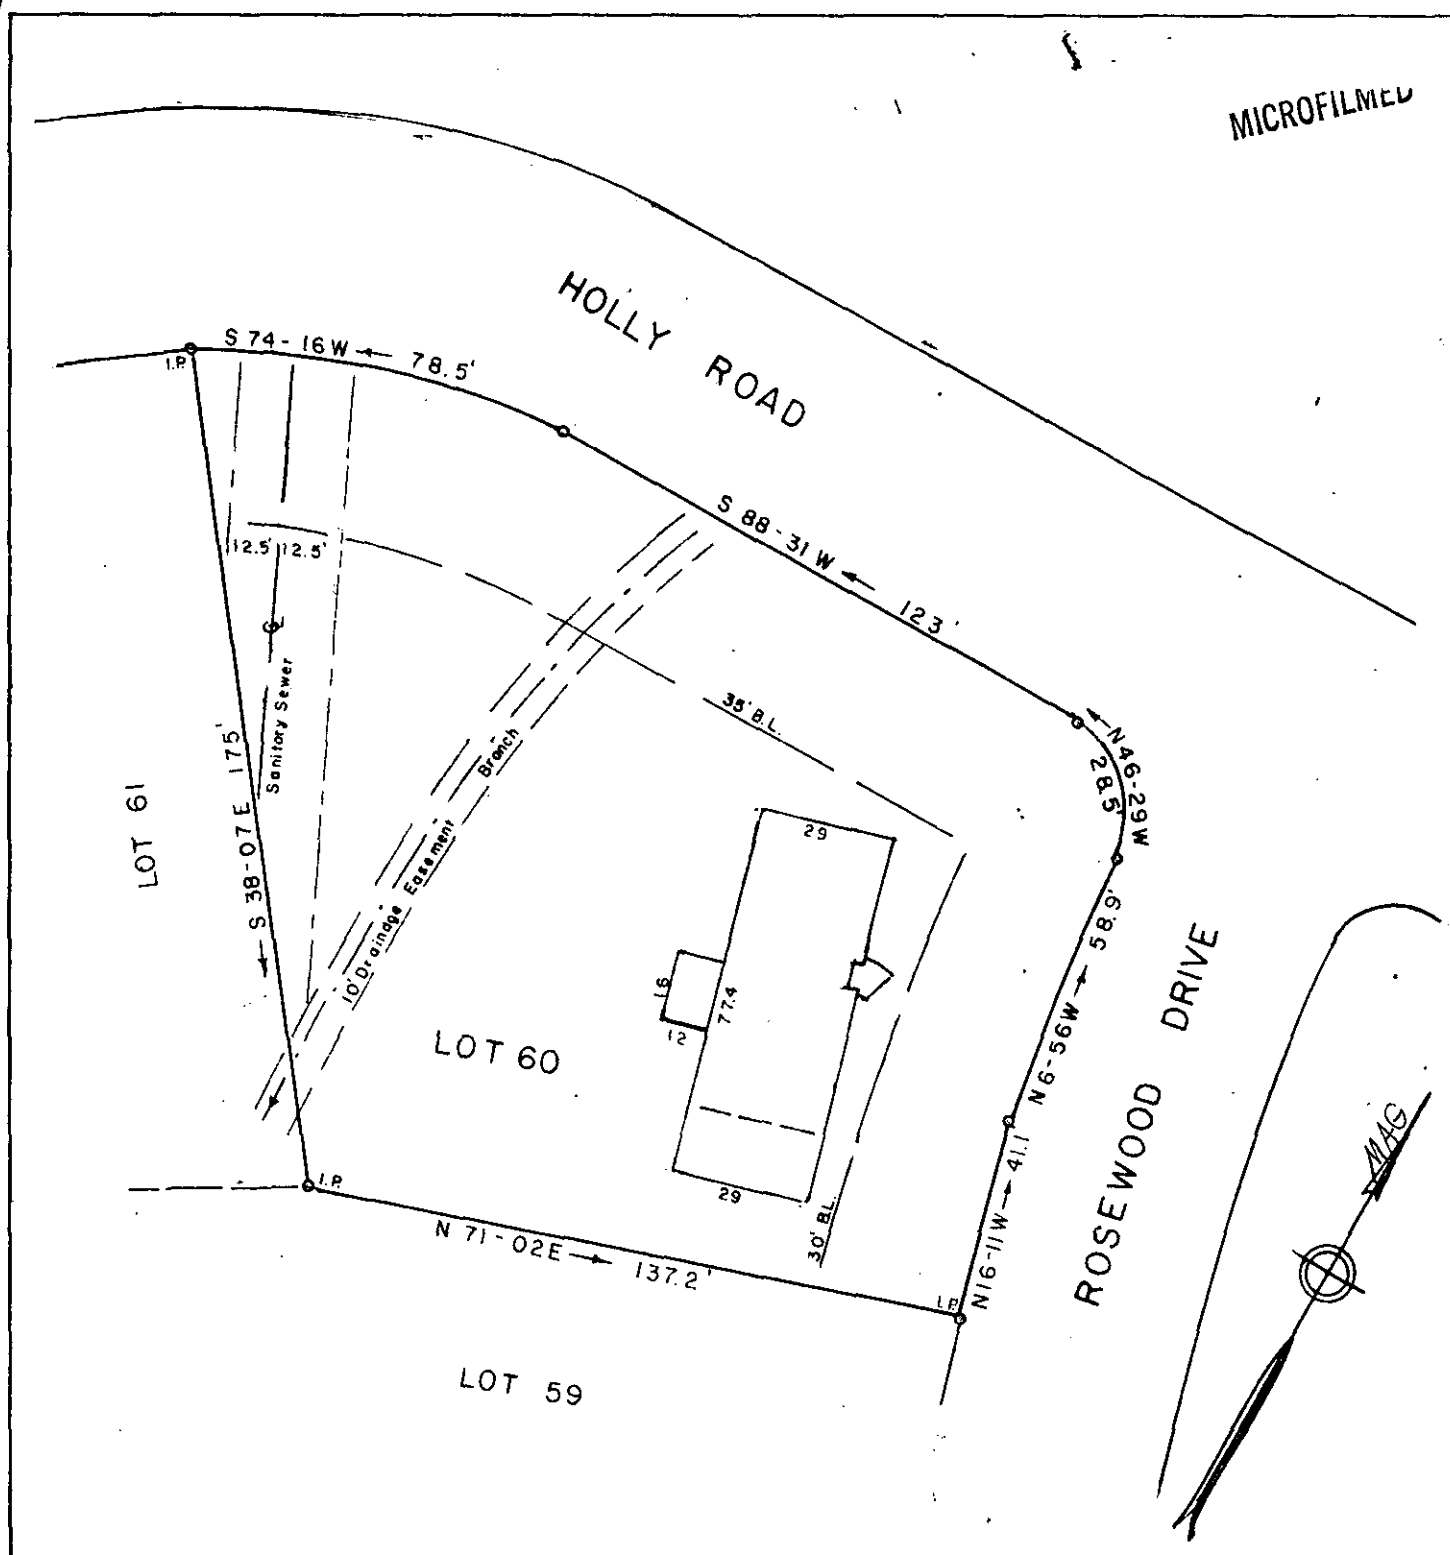

PROPERTY OF

FRANKLIN D. SMITH.
BARBARA ANN SMITH

GREENVILLE CO., S. C.

Scale 1" = 40' August, 1974

FILED
GREENVILLE CO. S. C.
AUG 16 4 27 PM '74
DONNIE S. TANKERSLEY
R.M.C.

This is to certify that on the 6th day of August, 1974, We surveyed the property shown on this plat; being known as Lot 60 on plat of Edward Forest Heights, Recorded in Plat Book 000 page 89, Office of R. M. C. Greenville Co., S. C.; and that the property lines, walls and buildings are as shown hereon; that the buildings located on said lot do not encroach or project on adjacent streets or property; and that no adjacent buildings or walls encroach or project on said premises.

RECORDING FEE
PAID \$ 2.00

R. W. Dalton
Dalton & Neves Co., Engineers. 4687