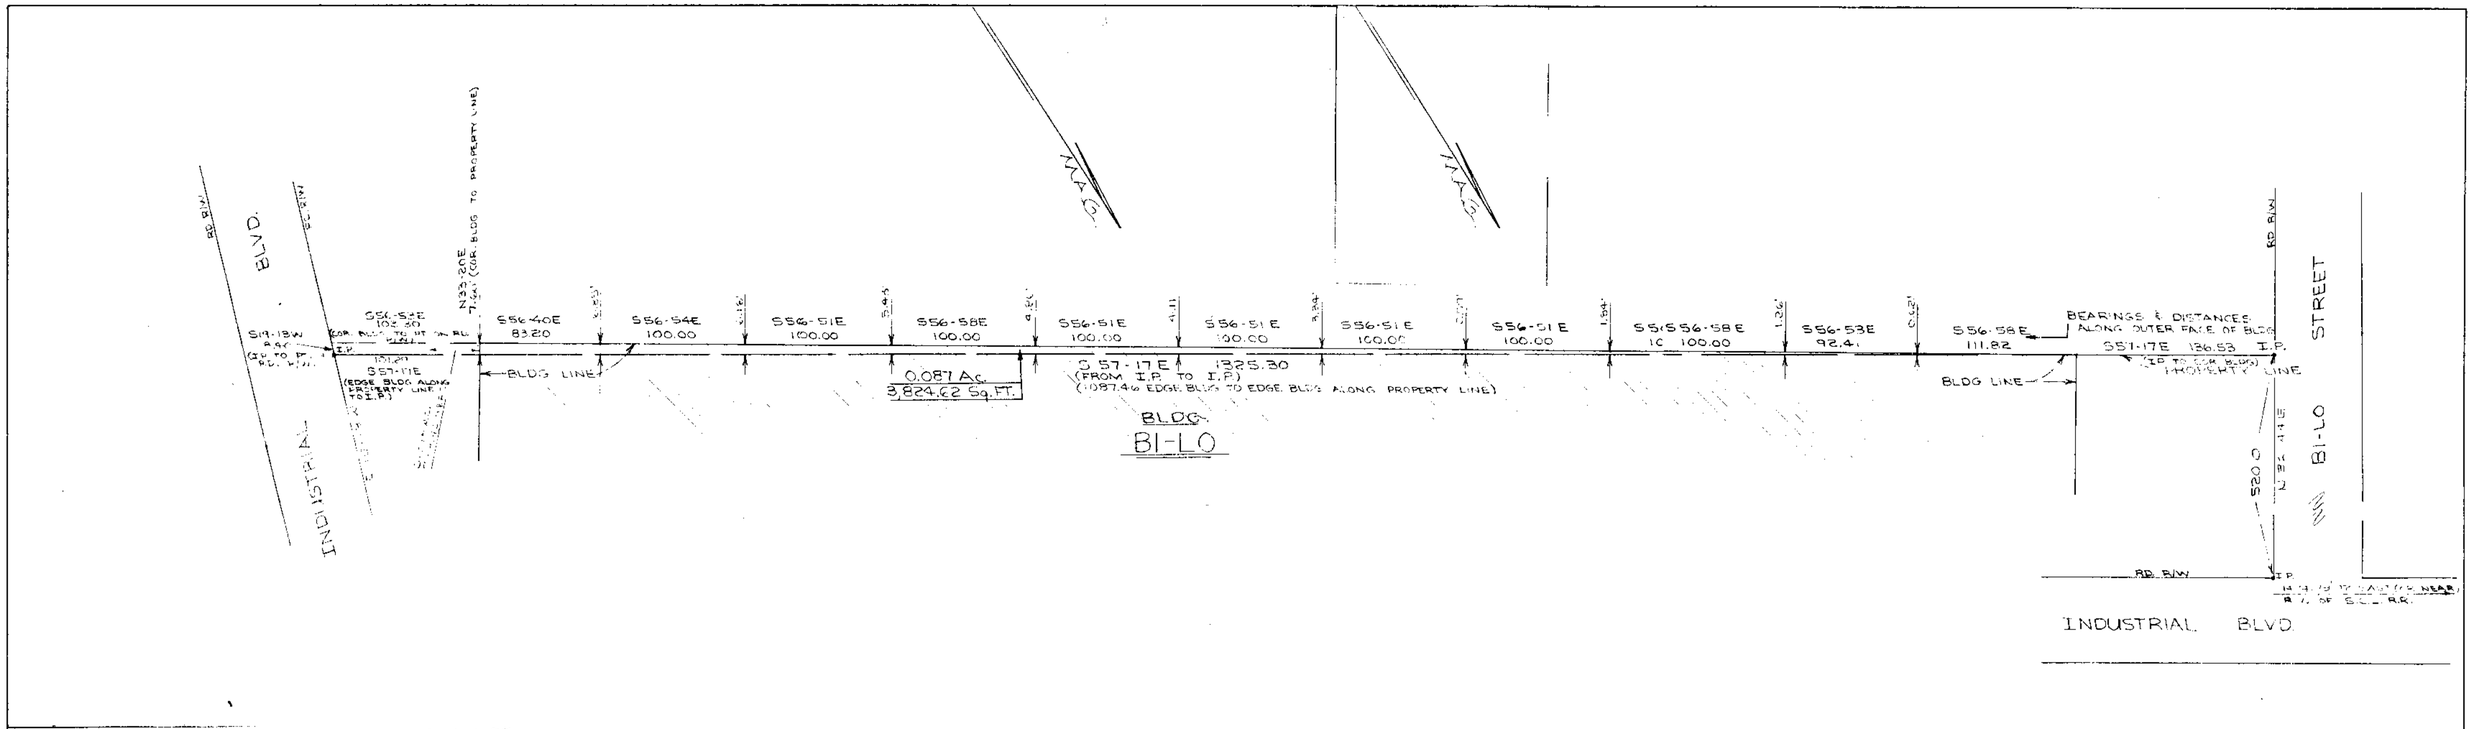

PLAT SHOWING ENCROACHMENT OF

BI-LO, INC.- WAREHOUSE

MAULDIN, S.C.
SCALE 1"=50'
16 JULY 1974

James D. Crain - Reg. No. 9330

Recording fee paid

FILED
GREENVILLE CO. S.C.
Oct 15 10 45 AM '74
DONNIE S. TANKERSLEY
R.M.C.

#9812

√5H-49

PIEDMONT ENGINEERS, ARCHITECTS, PLANNERS

PLAT SHOWING ENCROACHMENT OF

BI-LO, INC.- WAREHOUSE

MAULDIN, S.C.
SCALE 1"=50'
16 JULY 1974

FILED
GREENVILLE CO. S.C.
Oct 15 10 45 AM '74
DONNIE S. TANKERSLEY
R.M.C.

OCT 15

9812

SOUTH CAROLINA

MICROFILMED

PIEDMONT ENGINEERS, ARCHITECTS, PLANNERS √5-H 50

RECORDING FEE
PAID 4.00

23 X 17½