MICROFILMED

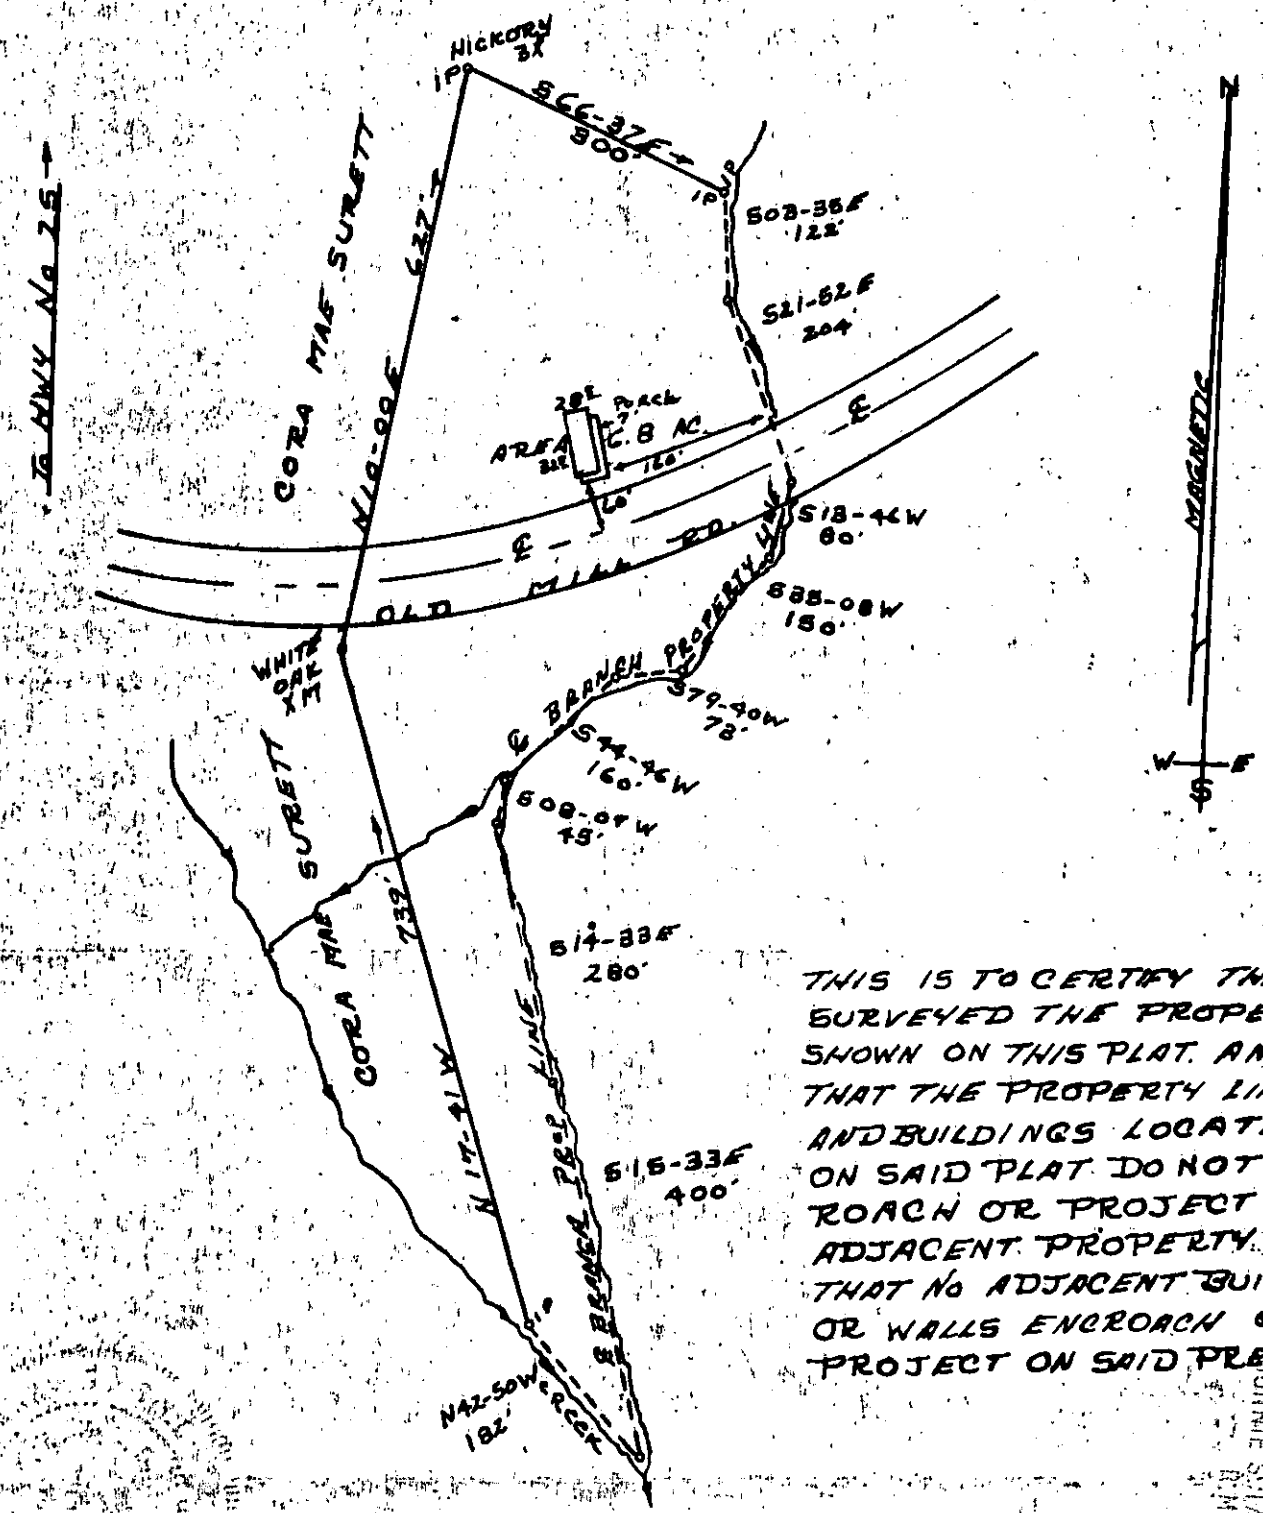

THIS IS TO CERTIFY THAT I SURVEYED THE PROPERTY SHOWN ON THIS PLAT. AND THAT THE PROPERTY LINES AND BUILDINGS LOCATED ON SAID PLAT DO NOT ENCROACH OR PROJECT ON ADJACENT PROPERTY AND THAT NO ADJACENT BUILDINGS OR WALLS ENCROACH OR PROJECT ON SAID PREMISES

PLAT OF PROPERTY
ROY LOCKABY
SOLD TO
GEORGE & CONNIE KILBOURNE

TERRY T. DILL
REG CE&LS
No 104
Rt 2 TAYLORS, S.C.

BATES TOWNSHIP GREENVILLE CO.
STATE OF SOUTH CAROLINA
8-20-74
SCALE 1" = 200'

13634

RECORDING FEE
PAID $ 1.00

DEC 2 1974

836-6970

5I-132

FILED
GREENVILLE CO. S.C.
DEC 2 11 57 AM '74
CONNIE S. TANKERSLEY
R.M.C.