MICROFILMED

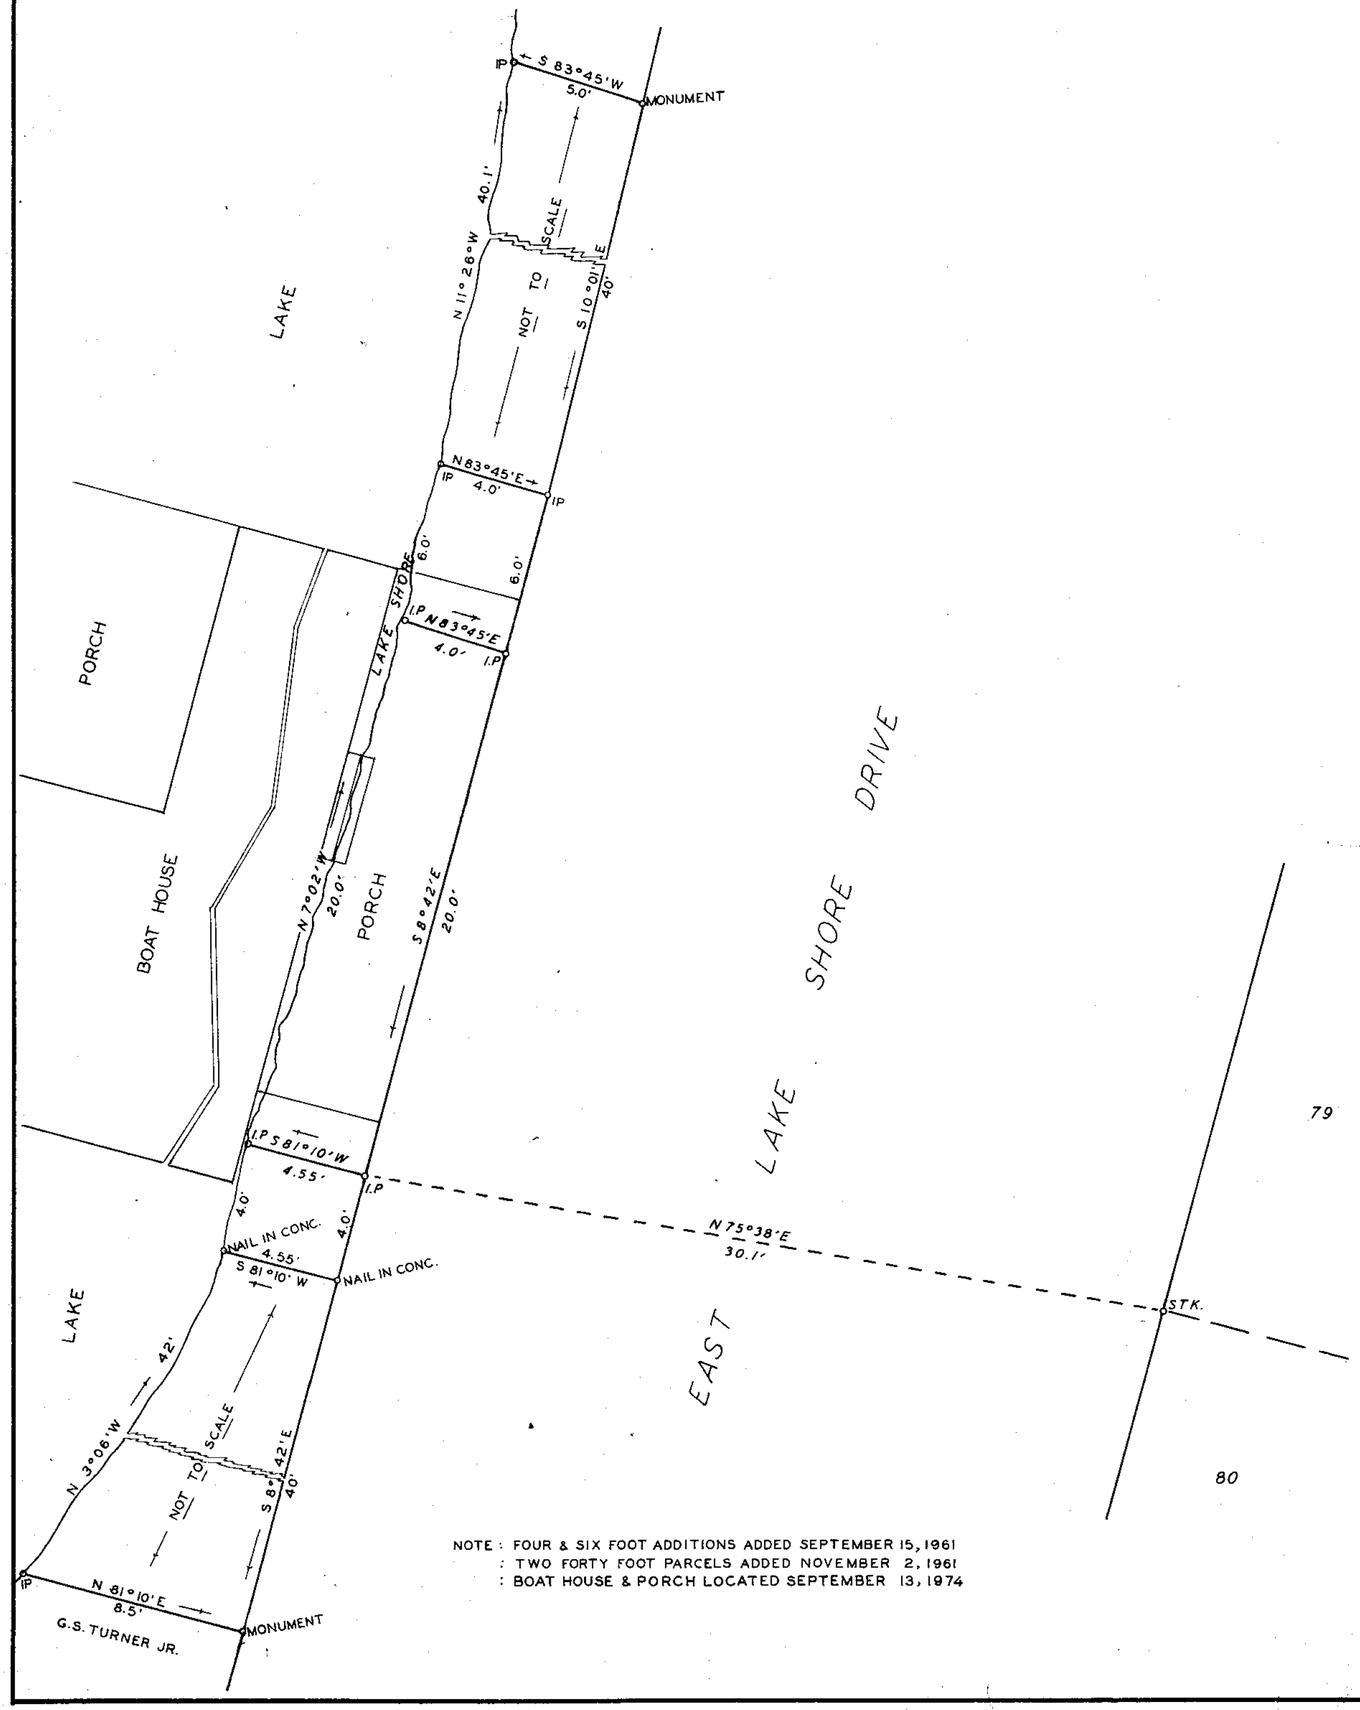

NOTE : FOUR & SIX FOOT ADDITIONS ADDED SEPTEMBER 15, 1961
: TWO FORTY FOOT PARCELS ADDED NOVEMBER 2, 1961
: BOAT HOUSE & PORCH LOCATED SEPTEMBER 13, 1974

PROPERTY BELONGING TO

ERNST MAHLER JR.

LAKE LANIER SUBDIVISON

GREENVILLE COUNTY S.C.

SCALE: 1 INCH = 4 FEET

H.B. FRANKENFIELD JR.

REG. SURVEYOR # 1164 S.C.

TRYON ~ N. CAROLINA

FEBRUARY 3, 1953

FILED
GREENVILLE CO. S.C.
JAN 9 4 16 PM '75
DONNIE S. TANKERSLEY
R.M.C.

RECORDING FEE
PAID $ 3.00

16378

444

V5 J-8