MICROFILMED

JAN 20 1976
FILED
GREENVILLE CO. S. C.
JAN 20 3 17 PM '76
DONNIE S. TANKERSLEY
R.M.C.

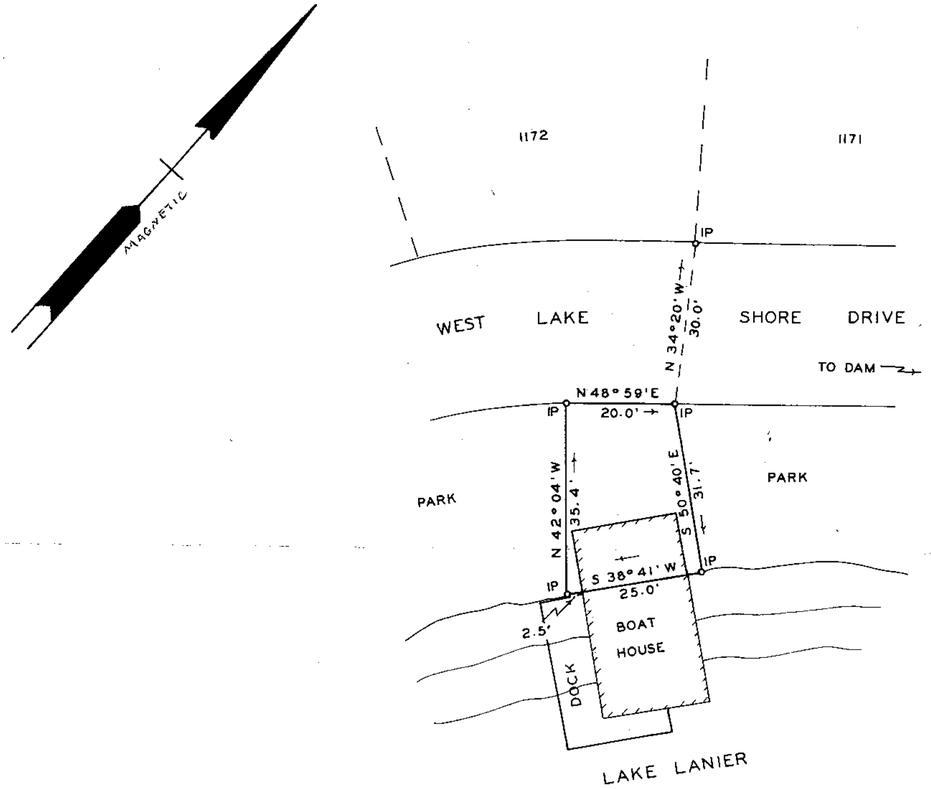

PROPERTY OWNED BY

A. B. COLLIER II ESTATE

CLAN-ALPINE SECTION - LAKE LANIER SUBDVN.

GREENVILLE COUNTY - S. CAROLINA

SCALE : 1 INCH = 20 FEET

OFFICE OF
H. B. FRANKENFIELD JR.
FOREST ENG. & SURVEYOR
TRYON - NORTH CAROLINA
NOVEMBER 25, 1975
Reg 1164

NOTE : PLAT REVISED NOV. 25, 1975 TO SHOW ADDITION TO BOAT HOUSE & DOCK.
ORIGINAL SURVEY JULY 30, 1957.

RECORDING FEE
PAID $ 3.00

15408
V5-J-95