



MICROFILMED

FILED
GREENVILLE CO. S. C.

JAN 6 11 09 AM '75

DONNIE S. TANKERSLEY
R.M.C.

BRYANT.

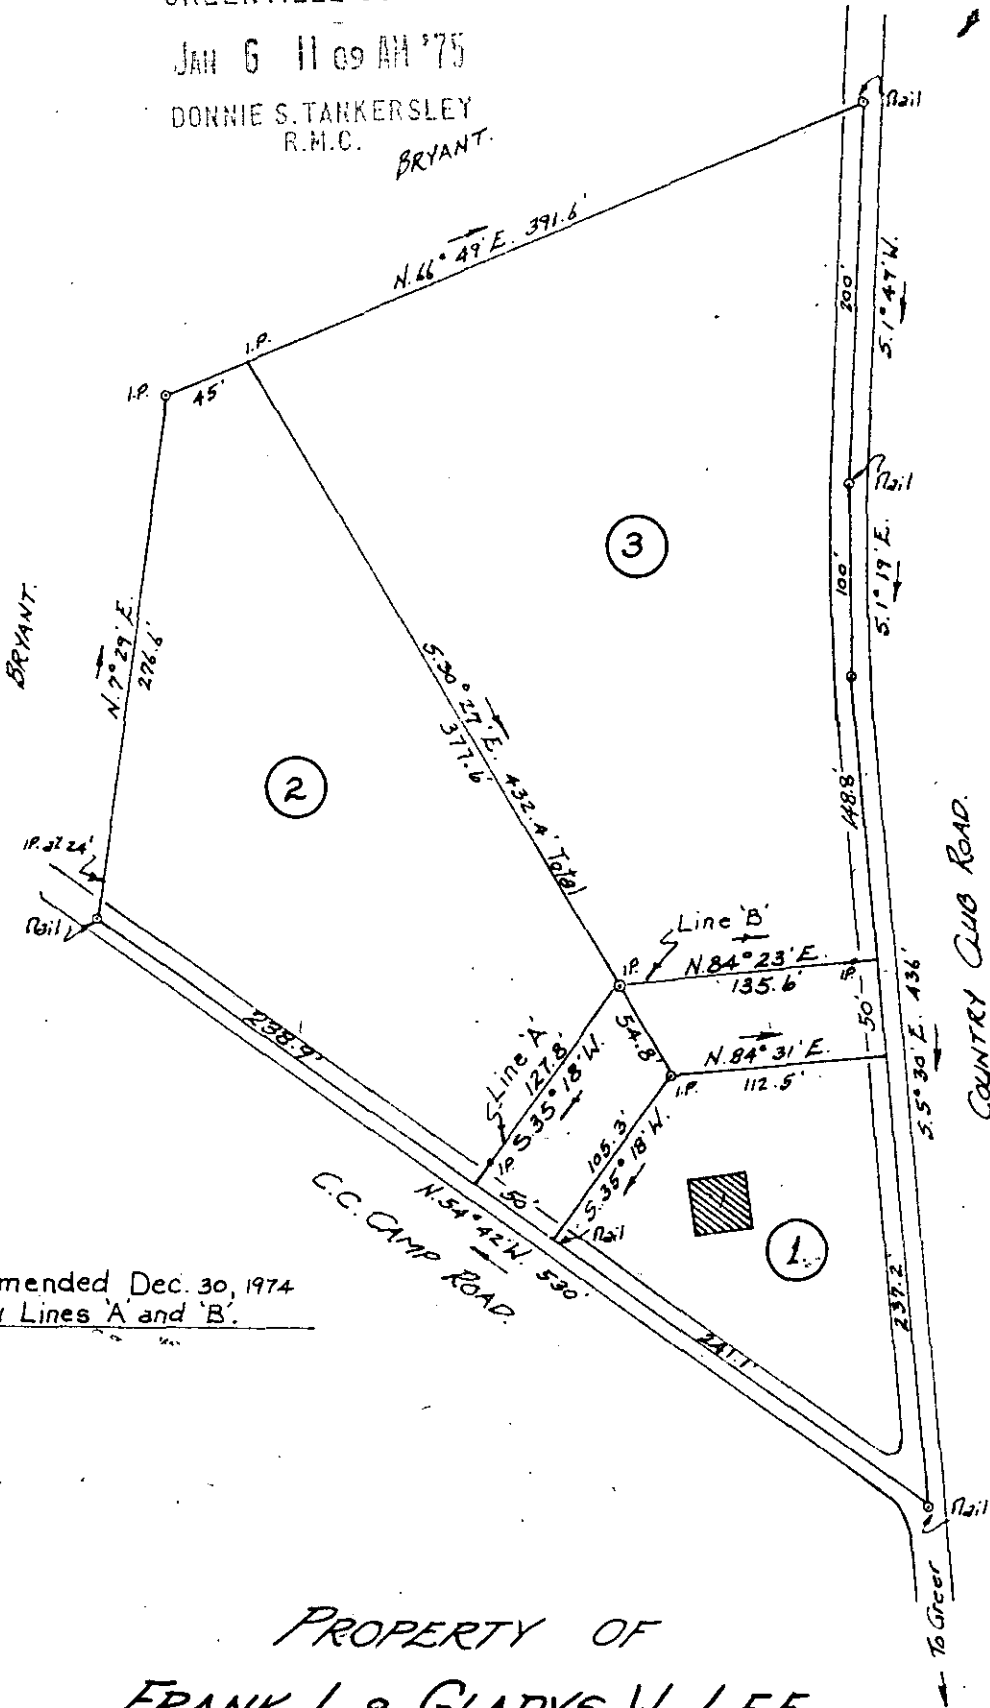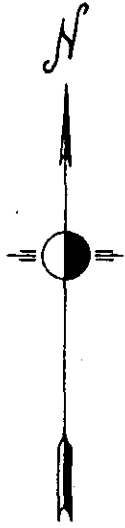

NOTE: Plat amended Dec. 30, 1974
to show Lines 'A' and 'B'.

PROPERTY OF
FRANK L & GLADYS W. LEE.

Located 2 miles North of Greer.

ONEAL TOWNSHIP GREENVILLE COUNTY
SOUTH CAROLINA.

SCALE: 1" = 100 FEET.

MARCH 12, 1959.

Survey made March 5 & 9, 1959.

15K-25

JAN 6 1975

16076



H.S. BROCKMAN, Reg. Surveyor #959.
GREER, S.C.
John A. Simmons - Draftsman.

RECORDING FEE
PAID \$ 1.00

8RB
10