


MICROFILMED

FILED  
GREENVILLE, CO. S. C.  
JAN 27 9 43 AM '75

BOBBIE S. TARKERS  
R.H.C.


SIMPSON ST.  
FORMERLY CHAPMAN RD.  
WATER & SEWER IN ST R/W

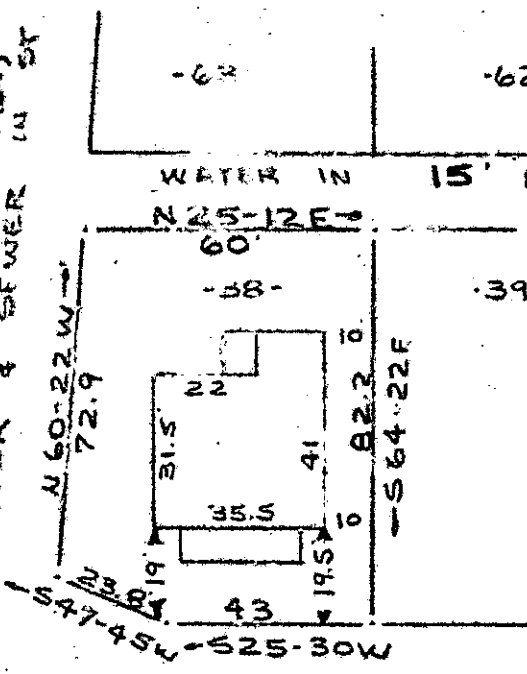

WEBB ST.

PROPERTY OF  
**WILLIAM R. ARROWOOD & SARAH B. ARROWOOD**  
 NEAR GREENVILLE, S.C.  
 SCALE: 1"=40' 22 JAN. 1975

This is to certify that on the 22nd day of January 1975, I surveyed the property shown on this plat, being known as lot 38 on plat of SECTION ONE DUNEAN MILLS and recorded in the RMC Office Greenville County, S. C., in Plat Book "S" at Pages 172 thru 177; and that the property lines, walls and buildings are as shown hereon, and that the walls and buildings located on said lot do not encroach or project on adjacent street or property, and that no adjacent walls or buildings encroach or project on said premises, and no power lines cross this property except as shown hereon. Also being known as PROPERTY OF WILLIAM R. ARROWOOD and SARAH B. ARROWOOD and recorded in Plat Book

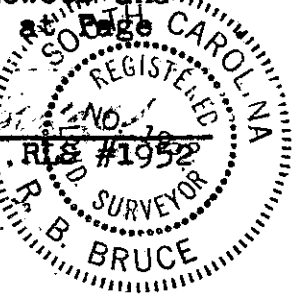

*R. B. Bruce*  
 R. B. Bruce, R.S. #1952

CAROLINA SURVEYING CO.  
 112 Manly St.  
 Greenville, S. C.

JAN 27 1975  
 15-K-46

17558

RECORDING FEE  
 \$ 1.00