


FILED  
 GREENVILLE CO. S. C.  
 MAR 3 11 12 AM '75  
 DONNIE S. TANKERSLEY  
 R.M.C.

PROPERTY OF  
**LELAND A. TRUAX**  
 GREENVILLE CO., S. C.

Scale 1" = 40' February, 1975

This is to certify that on the 24th day of February, 1975, We surveyed the property shown on this plat; being known as part of Lot 70, Section 1 on plat of Fresh Meadow Farms, Recorded in Plat Book S page 61, Office of R. M. C. Greenville Co., S. C.; and that the property lines, walls and buildings are as shown hereon; that the buildings located on said lot do not encroach or project on adjacent streets or property; and that no adjacent buildings or walls encroach or project on said premises.

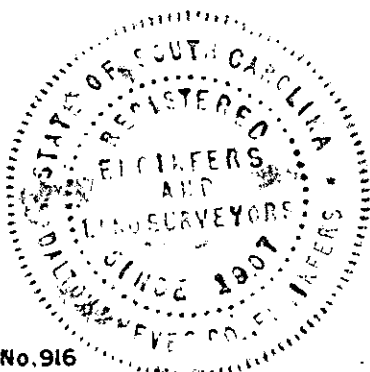

*R. W. Dalton*  
 -----  
 Dalton & Neves Co., Engineers.

20285

MAR 3 1975  
 RECORDING FEE  
 PAID \$ 1.00