
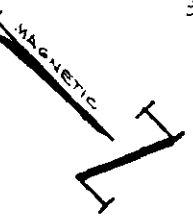


DEL NORTE LANE

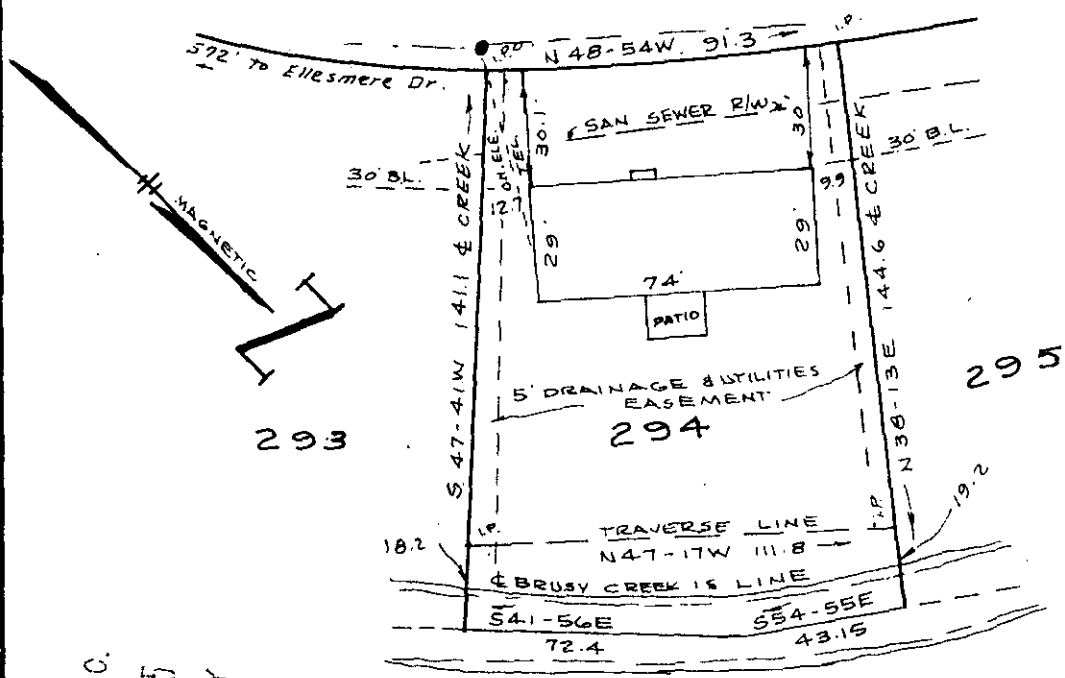

FILED
GREENVILLE, CO. S.C.
MAR 3 10 10 PM '75
DORRIS S. TANKERSLEY
R.H.C.

PROPERTY OF
GANESAN & DONA R. SUNDARESAN
GREENVILLE, CO. SOUTH CAROLINA

SCALE 1"=50' FEB 27, 1975 **20289**

This is to certify that on the 27th. day of February, 1975, I surveyed lot No. 294, Plat of Del Norte Estates Section 2, filed in plat book 4N pages 12 and 13, and the property lines, walls and buildings are as shown hereon; that the buildings located on said property do not encroach or project on adjacent streets or property; and that no adjacent walls, buildings or power lines encroach or project on said premises except as shown hereon.

MAR 3 1975

✓ 5-K-73

RECORDING FEE
PAID \$ 1.00

C.O. Riddle
Reg. L.S. 1347, Greenville

