


FILED
GREENVILLE CO. S.C.
MAR 7 4 35 PM '75
DONNIE S. TANKERSLEY
R.M.C.

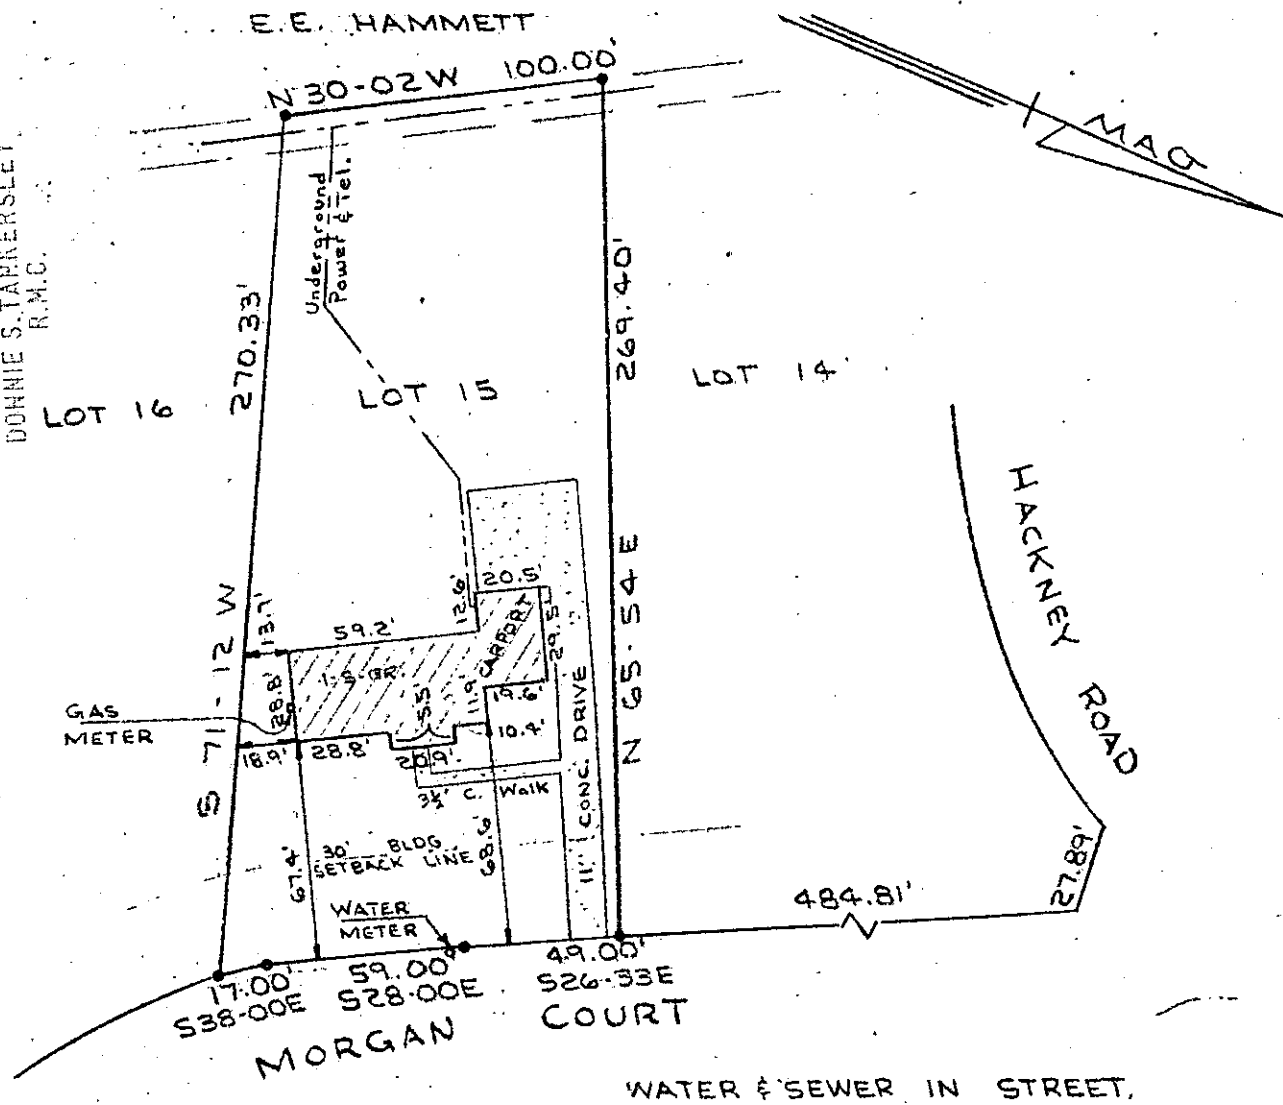


WATER & SEWER IN STREET.

This is to certify that on the 3rd day of March, 1975 I surveyed the property shown on this plat and that the property lines, walls and buildings are as shown hereon; that the buildings located on said lot do not encroach or project on adjacent streets or property; that no adjacent walls or building encroach or project on this lot and that there are no utility lines crossing this property except as shown.

✓5-K-78

MAR 7 1975

Aaron M. Thompson
Registered Land Surveyor No. 3616

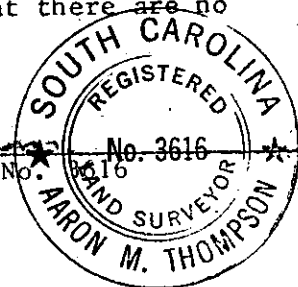

PROPERTY OF
R. CHARLES ELDRIDGE, JR.
& DIANA A. ELDRIDGE
RIVER DOWNS

LOT 15
GREENVILLE CO., S.C. SCALE 1"=60'

MAR. 3, 1975
PIEDMONT ENGINEERS and ARCHITECTS
GREENVILLE, S. C.

20749

RECORDING FEE
PAID \$ 1.00