


APPROX. 185' TO
SHERBORNE DRAVE

PART LOT 481

CRUBBS

SHERBORNE COURT

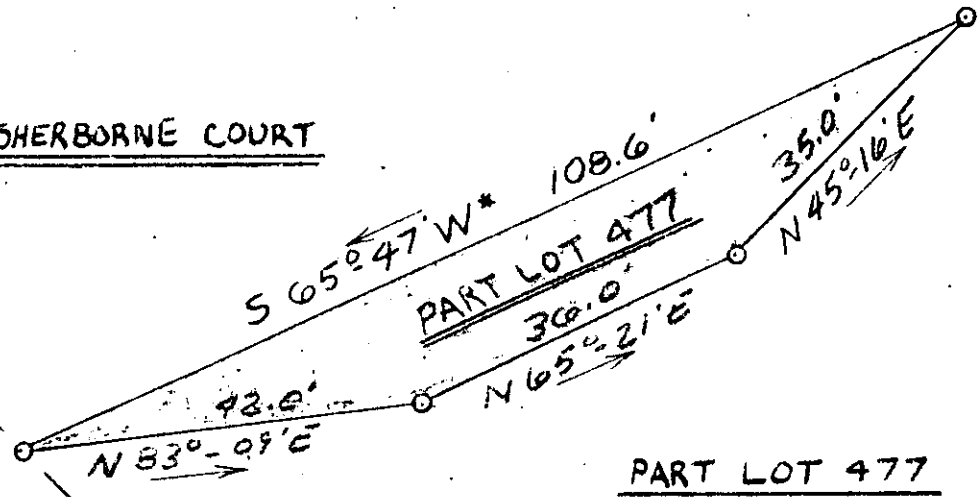

PART LOT 477



FILED
GREENVILLE CO. S.C.
APR 14 2 46 PM '75
DORRIS S. TANKERSLEY
R.H.C.

* BEARINGS REVISED FROM
PLAT ON RECORD BY FREDMONT
ENG. DUE TO MISPRINT ON
ORIGINAL PLAT.

NOTE: I.P.'S @ ALL CORNERS



23697

APR 14 1975

✓ 5K-116

RECORDING FEE
PAID \$ 1.00

REF: PLAT BOOK 4R ON PAGE 16.

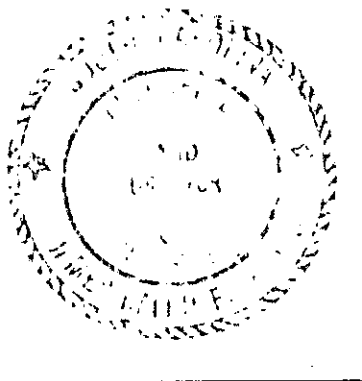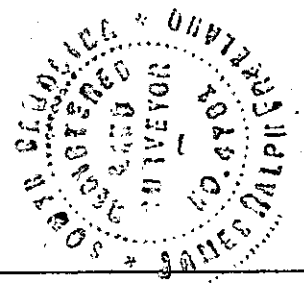

SEAL

**STATE OF SOUTH CAROLINA
GREENVILLE COUNTY**

DEL NORTE ESTATES
PART LOT 477 SEC. 3A
PROPERTY OF
LAWRENCE W. YEARGIN, Jr.
NANCY M. YEARGIN

**FREELAND-JONES
&
ASSOCIATES**
GREENVILLE, S.C.

SURVEY J.R.F. & R.S.J.
DRAWN F.E.L.
CHECK J.R.F.
SCALE 1"=20'
DATE 5-9-74
DWO. NO. 74-113