MICROFILMED

FILED
GREENVILLE CO. S. C.
MAY 5 10 40 AM '75
DONNIE S. TANKERSLEY
R.H.C.

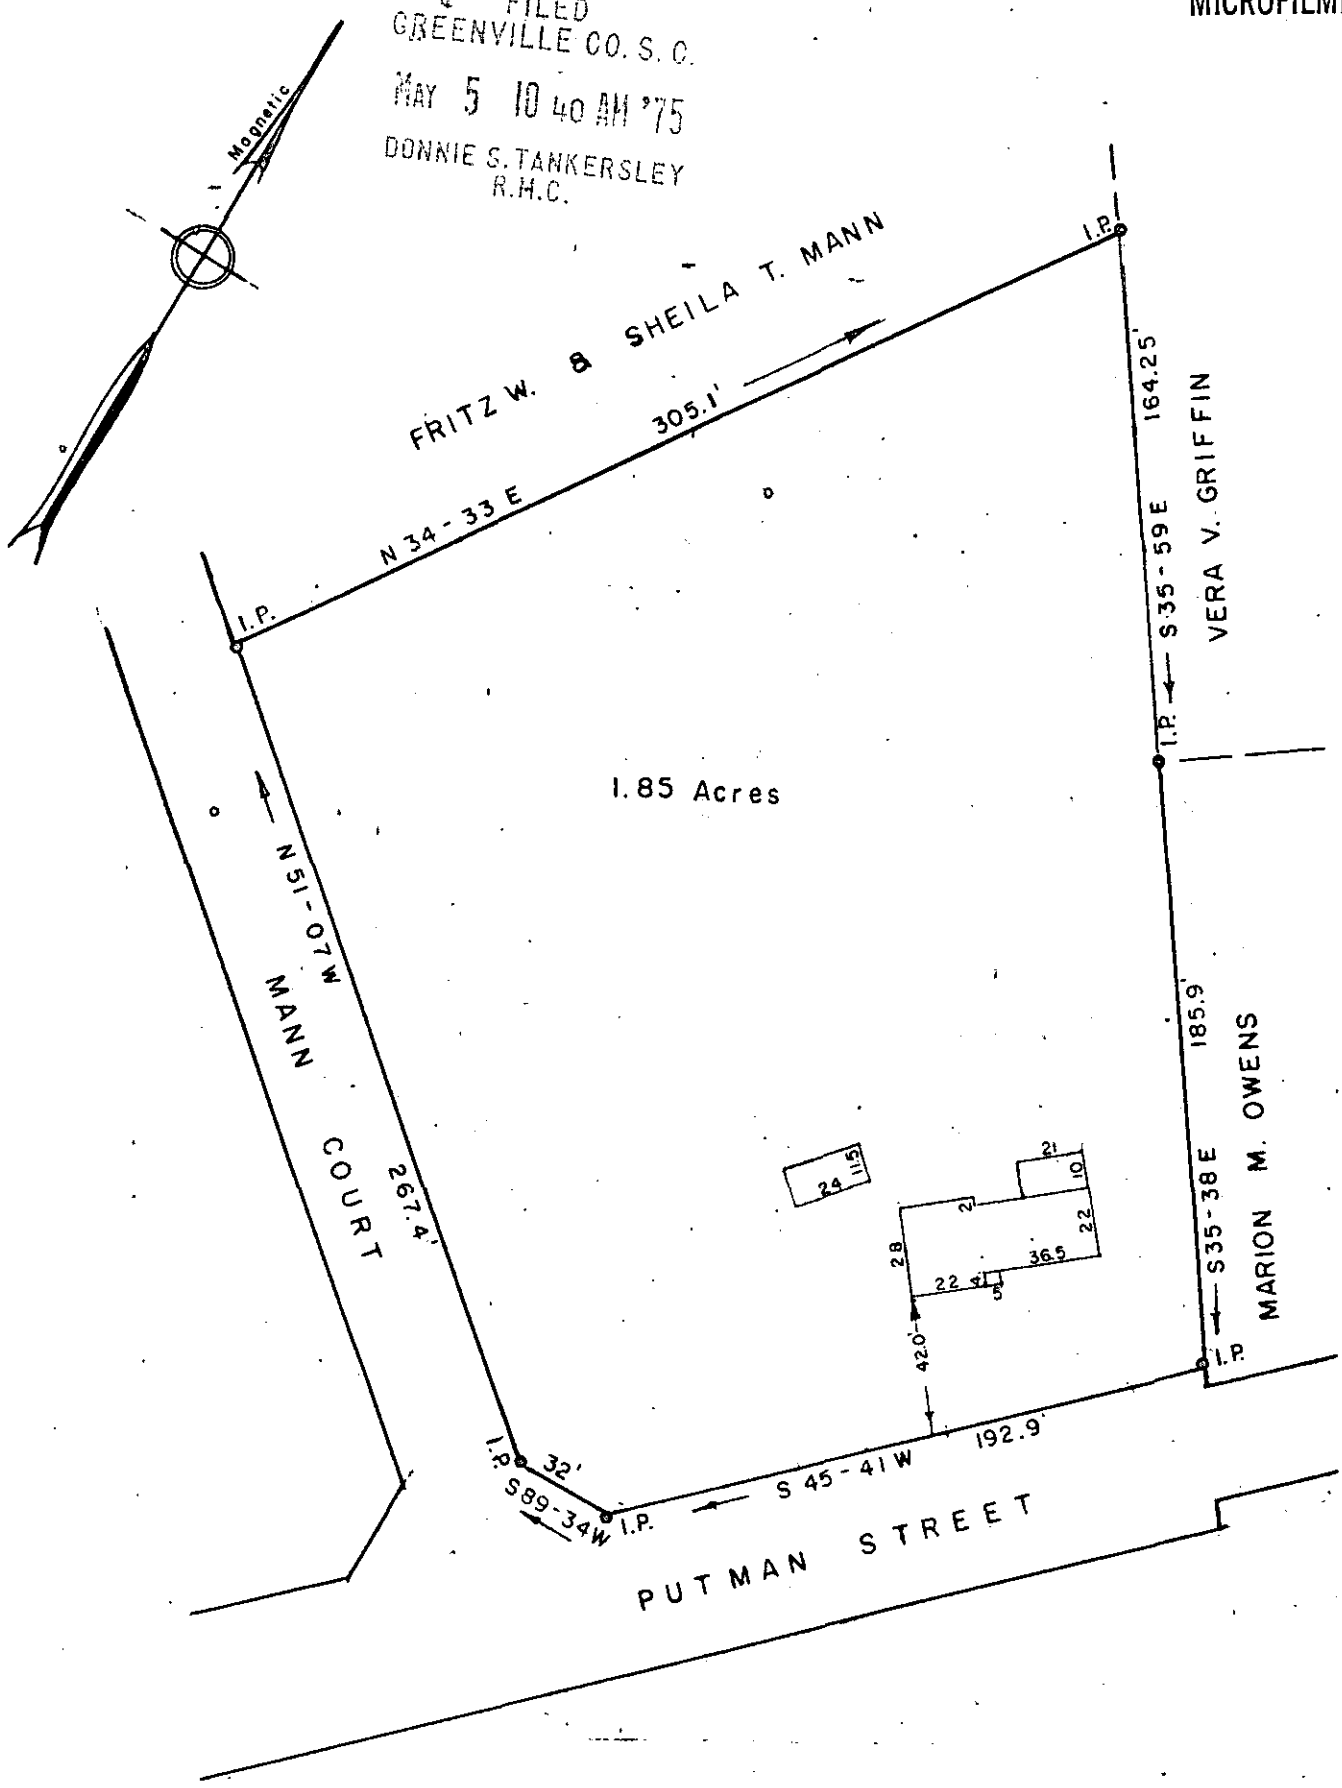

PROPERTY OF

DOUGLAS R. BLAKE

GREENVILLE COUNTY

SIMPSONVILLE, S.C. 5-L-27

Scale 1" = 60' May, 1975 MAY 5 1975

This is to certify that on the 1st day of May, 1975, We surveyed the property shown on this plat; being shown on plat of Douglas R. Blake, Recorded in Plat Boook Page Office of R. M. C. Greenville Co., S. C.; and that the property lines, walls and buildings are as shown hereon; that the buildings located on said property do not encroach or project on adjacent streets or property; and that no adjacent buildings or walls encroach or project on said premises.

STATE OF SOUTH CAROLINA REGISTERED ENGINEERS AND LAND SURVEYORS SINCE 1907 DALTON & NEVES CO.

R. W. Dalton

Dalton & Neves Co., Engineers.
121 Manly Street
Greenville, South Carolina

25611

F. B. 411

S. C. Reg. No. 916

RECORDING FEE
PAID $ 2.00