


PROPERTY OF  
 GLENN DOUGLAS KIRBY  
 PATRICIA M. KIRBY  
 GREENVILLE COUNTY  
 FOUNTAIN INN, S. C.

Scale 1" = 40' June, 1975

FILED  
 GREENVILLE CO. S.C.  
 JUN 23 10 36 AM '75  
 DONNIE S. TANKERSLEY  
 R.M.C.

This is to certify that on the 19th day of June, 1975; We surveyed the property shown on this plat; being known as Lot 2 on plat of W. A. Roberts, dated June 4, 1957, also being known as Lot 2 on plat of Glenn Douglas Kirby and Patricia M. Kirby, Recorded in Plat Book page Office of R. M. C. Greenville Co., S. C.; and that the property lines, walls and buildings are as shown hereon; that the buildings located on said lot do not encroach or project on adjacent streets or property; and that no adjacent buildings or walls encroach or project on said premises.

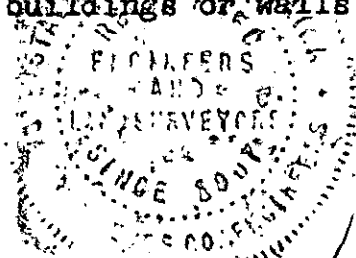

30270  
*R. W. Dalton*  
 Dalton & Neves Co., Engineers  
 121 Manly Street  
 Greenville, South Carolina  
 JUN 23 1975

✓ 52-44

RECORDING FEE  
 PAID \$ 2.00