


LOT 4

MICROFILMED

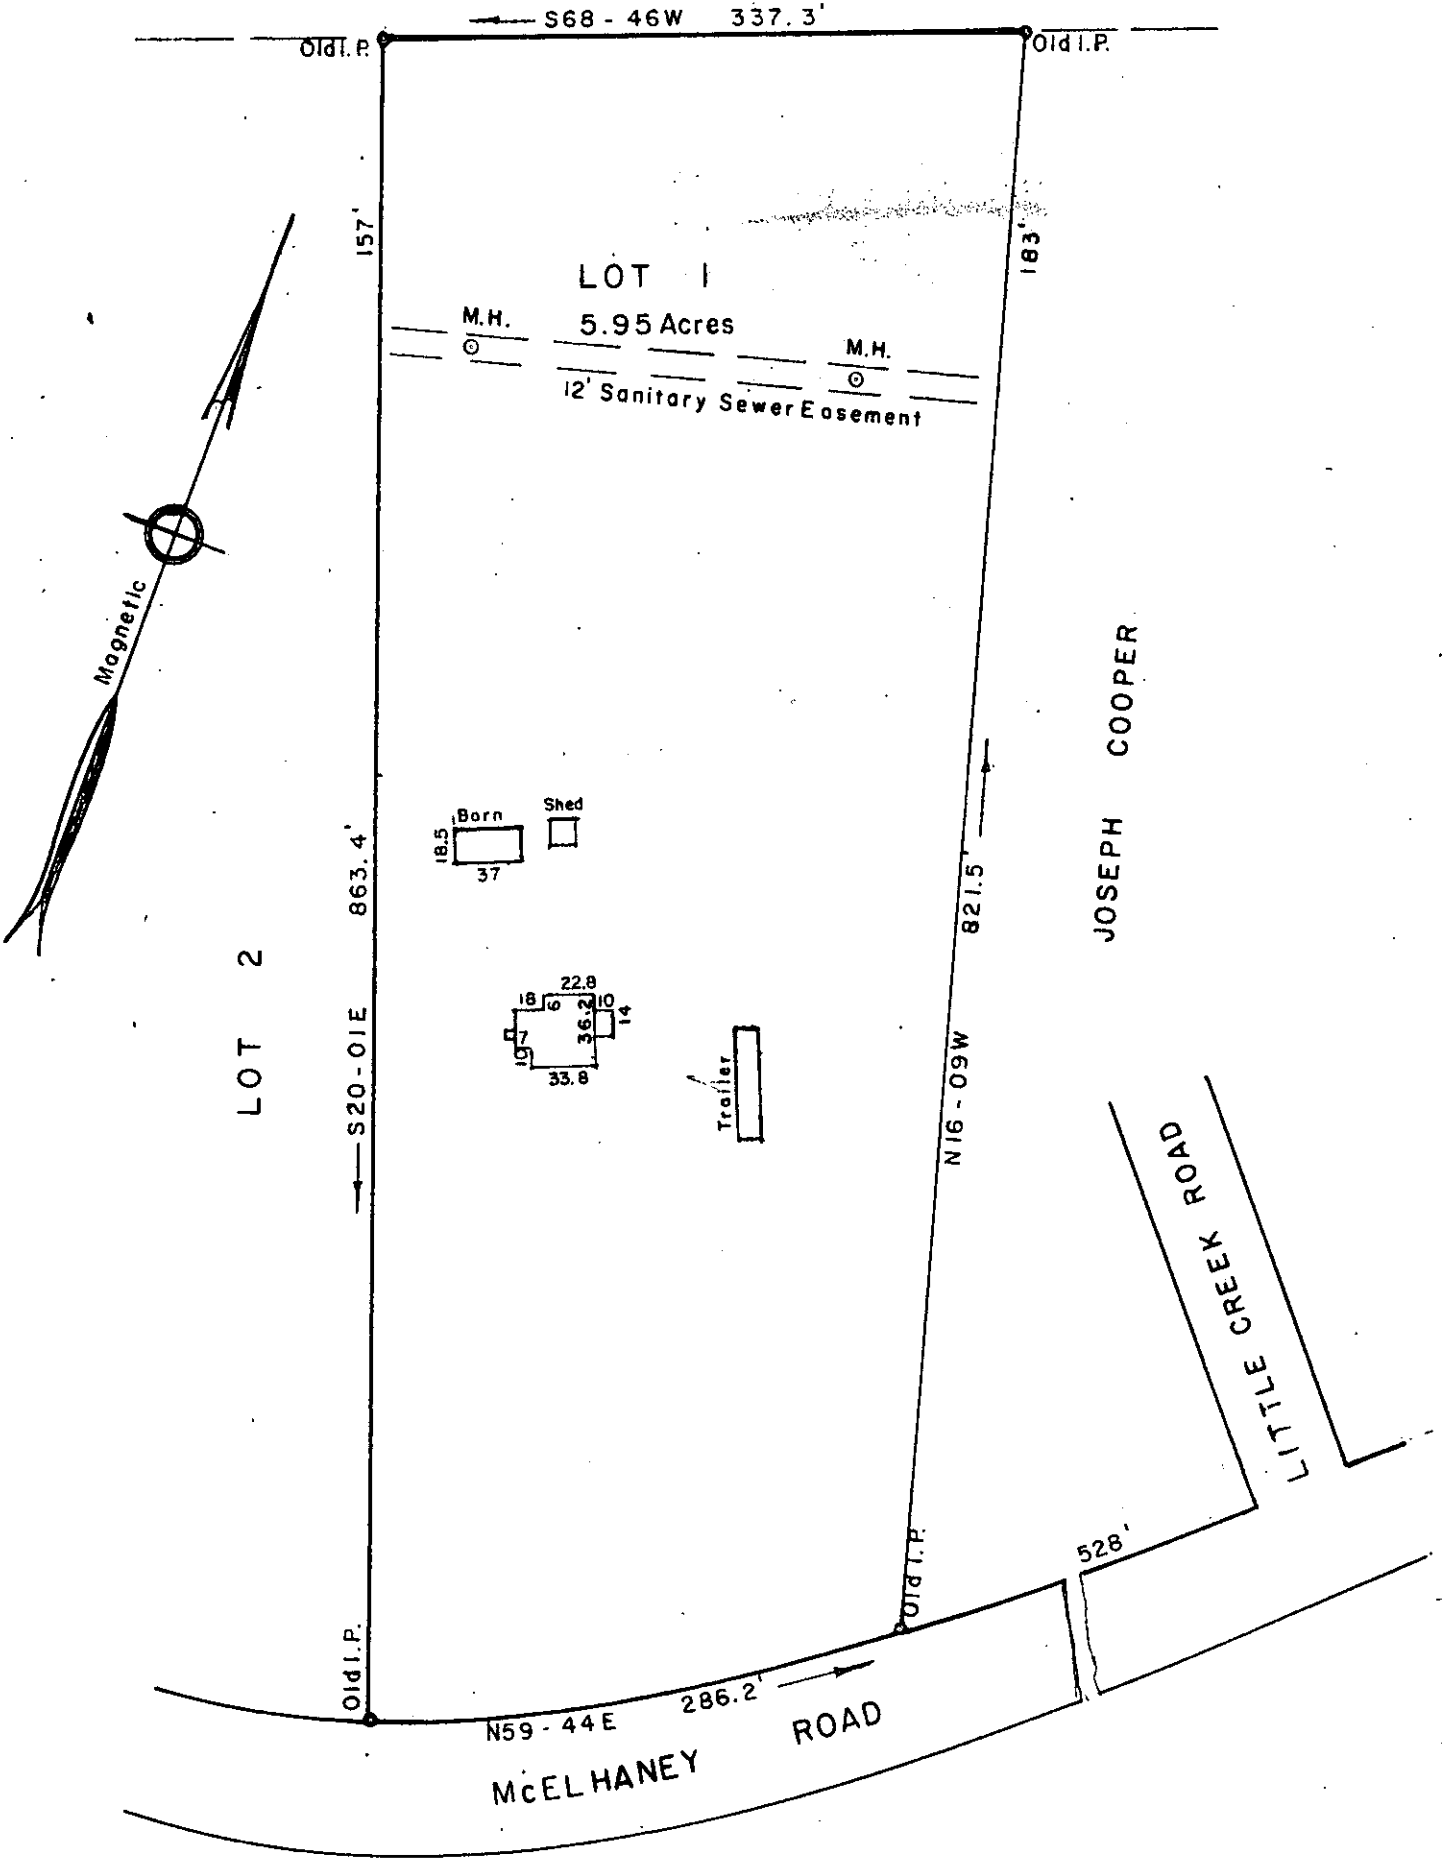


PROPERTY OF
KENNETH EARL FLANAGAN

GREENVILLE CO., S.C.

Scale: 1" = 100' June, 1975

This is to certify that on the 5th day of June, 1975, We surveyed the property shown on this plat; being known as Lot 1 on plat of George W. Bridwell, Recorded in Plat Book M page 129, Office of R. M. C. Greenville Co., S. C.; and that the property lines, walls and buildings are as shown hereon; that the buildings located on said lot do not encroach or project on adjacent streets or property; and that no adjacent buildings or walls encroach or project on said premises.

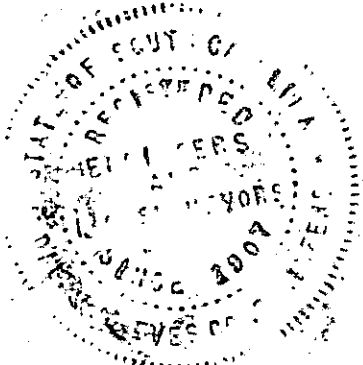

R. W. Dalton

Dalton & Neves Co., Engineers.

R.M.C.
DONNIE S. TANKERSLEY
JUN 23 12 15 PM '75
GREENVILLE CO. S.C.

JUN 23 1975
172071

RECORDING FEE
PAID \$ 200

S. C. Reg. No. 916
F.B. 405

56-45

FILED