


FILED
GREENVILLE CO. S. C.

AUG 25 4 57 PM '75


DONNIE S. TANKERSLEY
R.M.C.

MICROFILMED

M. J. MILLER

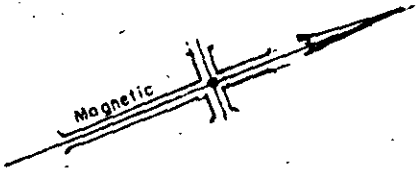

BROOKWOOD DRIVE

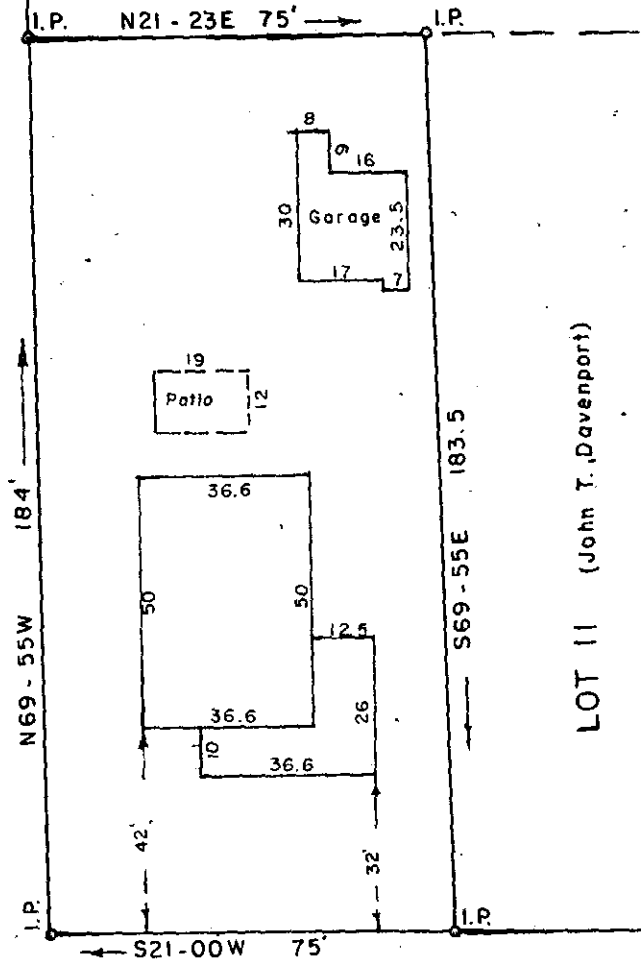

WEST FARIS ROAD

PROPERTY OF
 THERON A. TILTON
 SHARON T. TILTON
 GREENVILLE, S. C.

Scale 1" = 40' August, 1975

This is to certify that on the 7th day of August, 1975, We surveyed the property shown on this plat; being shown on plat of Theron A. Tilton and Sharon T. Tilton, Recorded in Plat Book 54, page 75, Office of R. M. C. Greenville Co., S. C.; and that the property lines, walls and buildings are as shown hereon; that the buildings located on said plat do not encroach or project on adjacent streets or property; and that no adjacent buildings or walls encroach or project on said premises.



5037

R. W. Dalton

AUG 25 1975 Dalton & Neves Co., Engineers.

Mainly Street Greenville S.C.

✓ 5 L 75

RECORDING FEE
 PAID \$ 2.00

S.C. Reg. No. 916
F.B. 412