


FILED  
 GREENVILLE CO. S. C.  
 SEP 25 10 53 AM '75  
 DONNIE S. TANKERSLEY  
 R.M.C.

PROPERTY OF  
 E. JACOBS JOHNSON  
 MARY M. JOHNSON  
 GREENVILLE, S. C.

Scale 1" = 40' September, 1975

This is to certify that on the 23rd day of September, 1975, We surveyed the property shown on this plat; being known as Part Lot 1, Part Lot 2 and Lot 4 on plat of G. B. Lee, Recorded in Plat Book K page 43, which plat is a re-subdivision of Lots 1-2-3-7-8-9-10-11, Block B on plat of Carolina Court, Recorded in Plat Book FF page 96, Office of R. M. C. Greenville Co., S. C. and that the property lines, walls and buildings are as shown hereon; that the buildings located on said lots do not encroach or project on adjacent streets or property; and that no adjacent buildings or walls encroach or project on said premises.

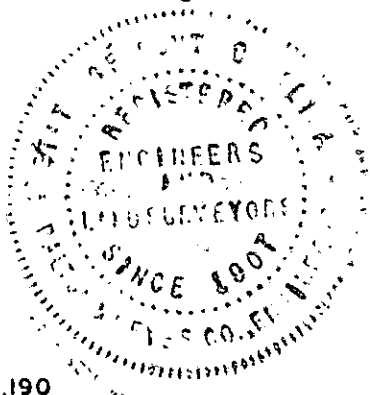

SEP 25 1975

*R. W. Dalton*  
 Dalton & Neves Co., Engineers

✓ 52-91

8038

RECORDING FEE  
 PAID \$ 2.00