


1. P.'S @ ALL CORNERS


315' ± TO DOVETREE ROAD

MICROFILMED

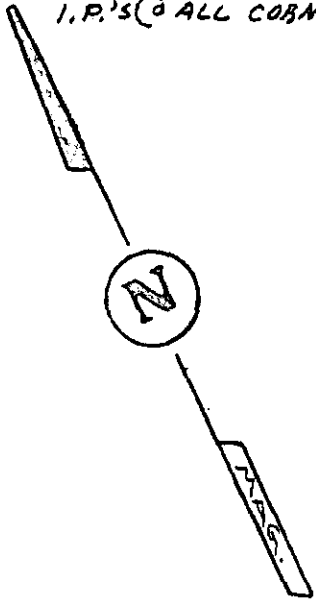

FILED
GREENVILLE CO. S.C.
JUN 23 1 12 PM '75
DONNIE S. TANKERSLEY
R.M.C.

STURBRIDGE DRIVE

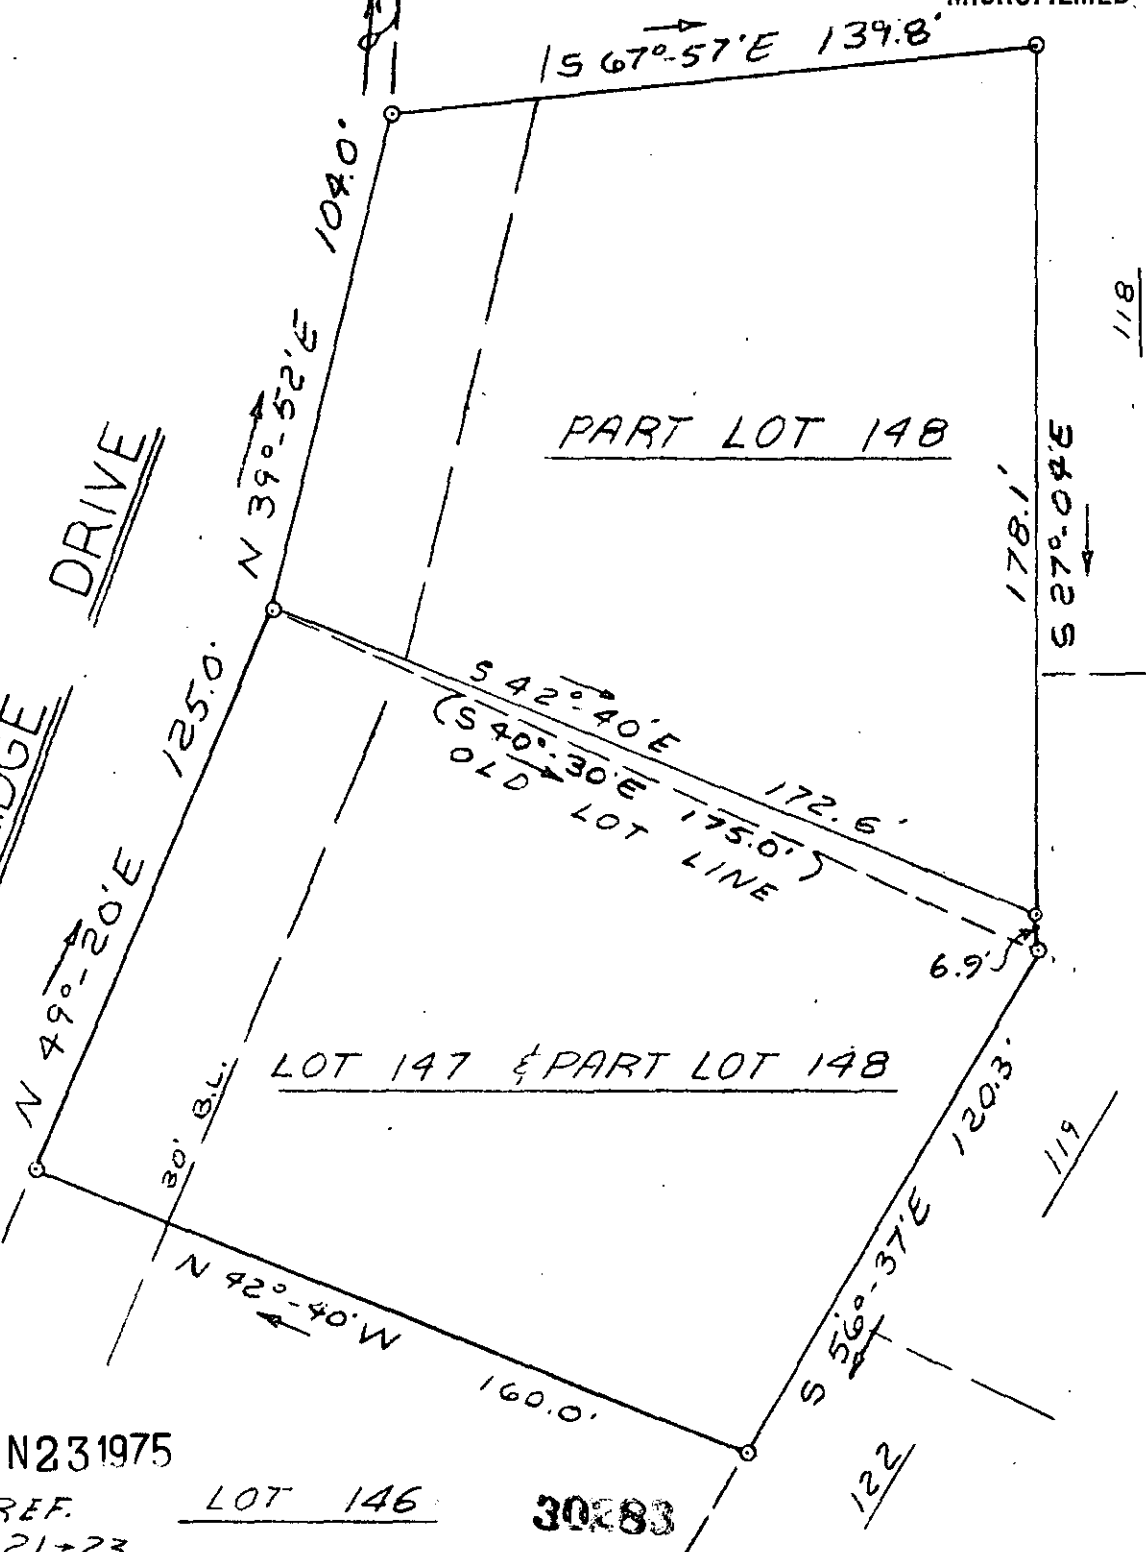


RECORDING FEE
PAID \$ 1.00

5M-70

JUN 23 1975

SUBDIVISION REF. LOT 146 30283
PLAT BOOK 4X-21-23

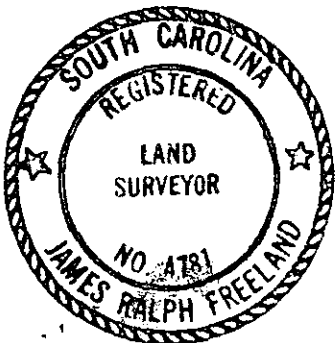

SEAL

**STATE OF SOUTH CAROLINA
GREENVILLE COUNTY**

DOVE TREE

REVISION OF
LOTS 147 & 148

PROPERTY OF

DOVE TREE REALTY COMPANY

FREELAND & ASSOCIATES
Engineers • Land Surveyors

GREENVILLE, S. C.

SURVEY F.L.

DRAWN F.L.

CHECK J.F.

SCALE 1"=40'

DATE 6-19-75

DWO. NO. 75-533