



ALABAMA AVENUE
WATER & SEWER IN ST. RW

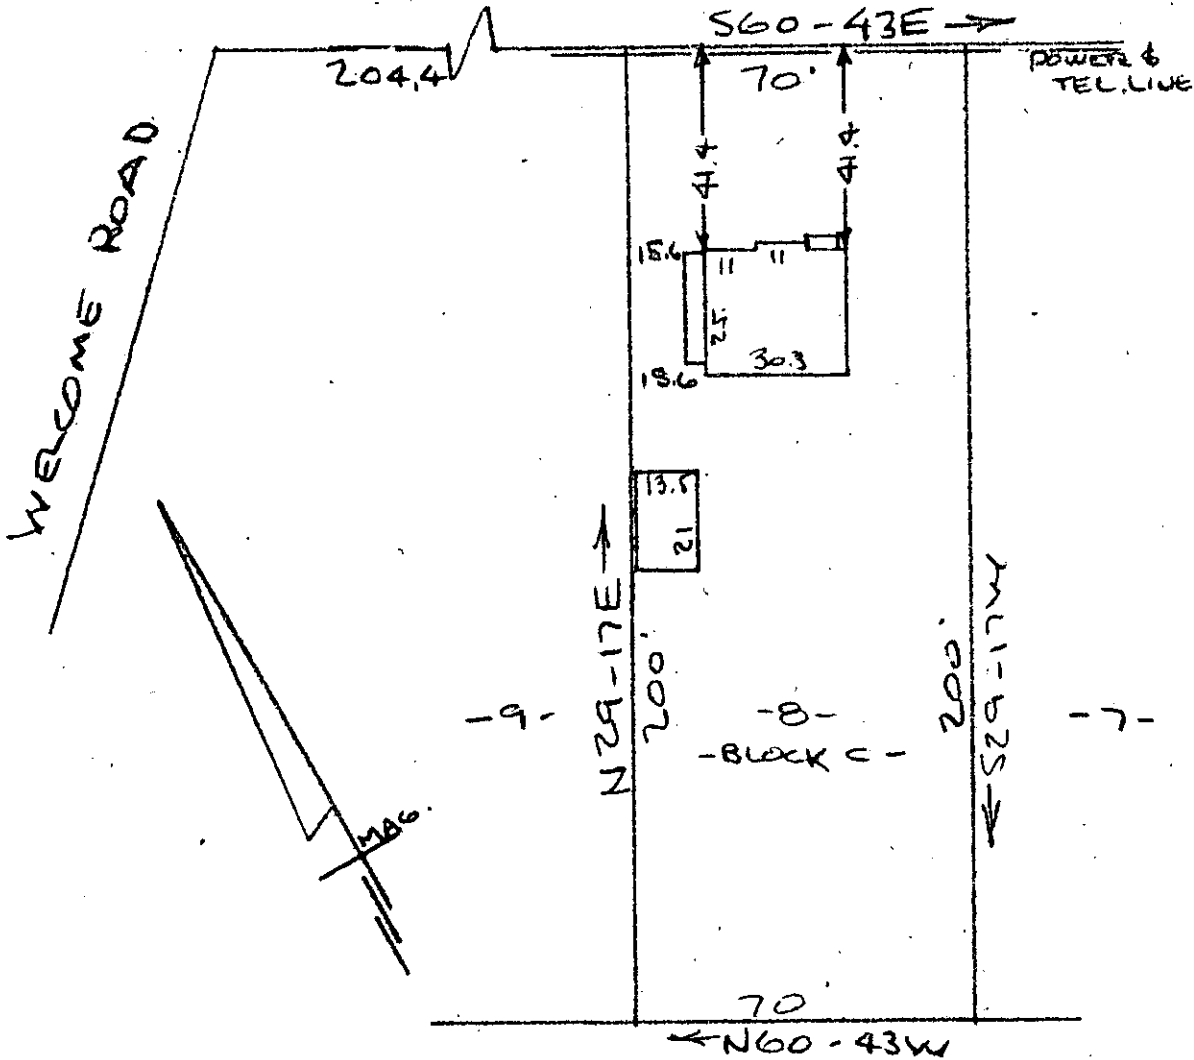

FILED
 GREENVILLE, S.C.
 JUL 31 11 39 AM '75
 DONNIE S. TANKERSLEY
 R.M.C.

PROPERTY OF
 KENNETH F. LOTHRIDGE & SHARON P. LOTHRIDGE
 NEAR GREENVILLE, S.C.
 SCALE: 1" = 40' 30 JULY 1975

This is to certify that on the 30th day of July 1975, I surveyed the property shown on this plat, being known as lot 8 Block "C" on a plat of PROP OF H. K. TOWNES and recorded in the RMC Office Greenville County, S.C., in Plat Book "W" at Page 13; and that the property lines, walls and buildings are as shown hereon, and that the walls and buildings located on said lot do not encroach or project on adjacent street or property, and that no adjacent buildings encroach or project on said premises, and no power lines cross this property except as shown hereon.

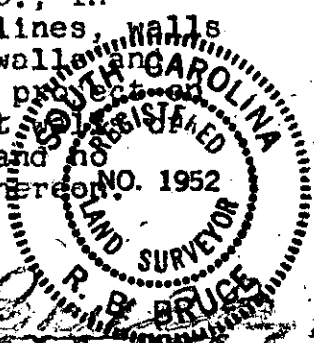

✓ 5m-132

2764

R. B. Bruce, R.L.S. #1952
 Carolina Surveying Co.
 112 Manly St.
 Greenville, South Carolina

RECORDING FEE
 PAID \$ 1.00