

NOTE: Plat amended Sept. 23 1975  
to show 0.46 Acre tract.

# PROPERTY OF HAROLD S. & FREDDIE C. CHEEKS.


Located approx 3 miles North of Greer.

GREENVILLE COUNTY,

SOUTH CAROLINA.


SCALE: 1" = 50 FEET.

SEPT. 4 1975

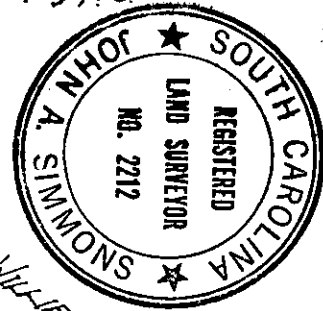

2.00 ACRES.

0.46 ACRE.

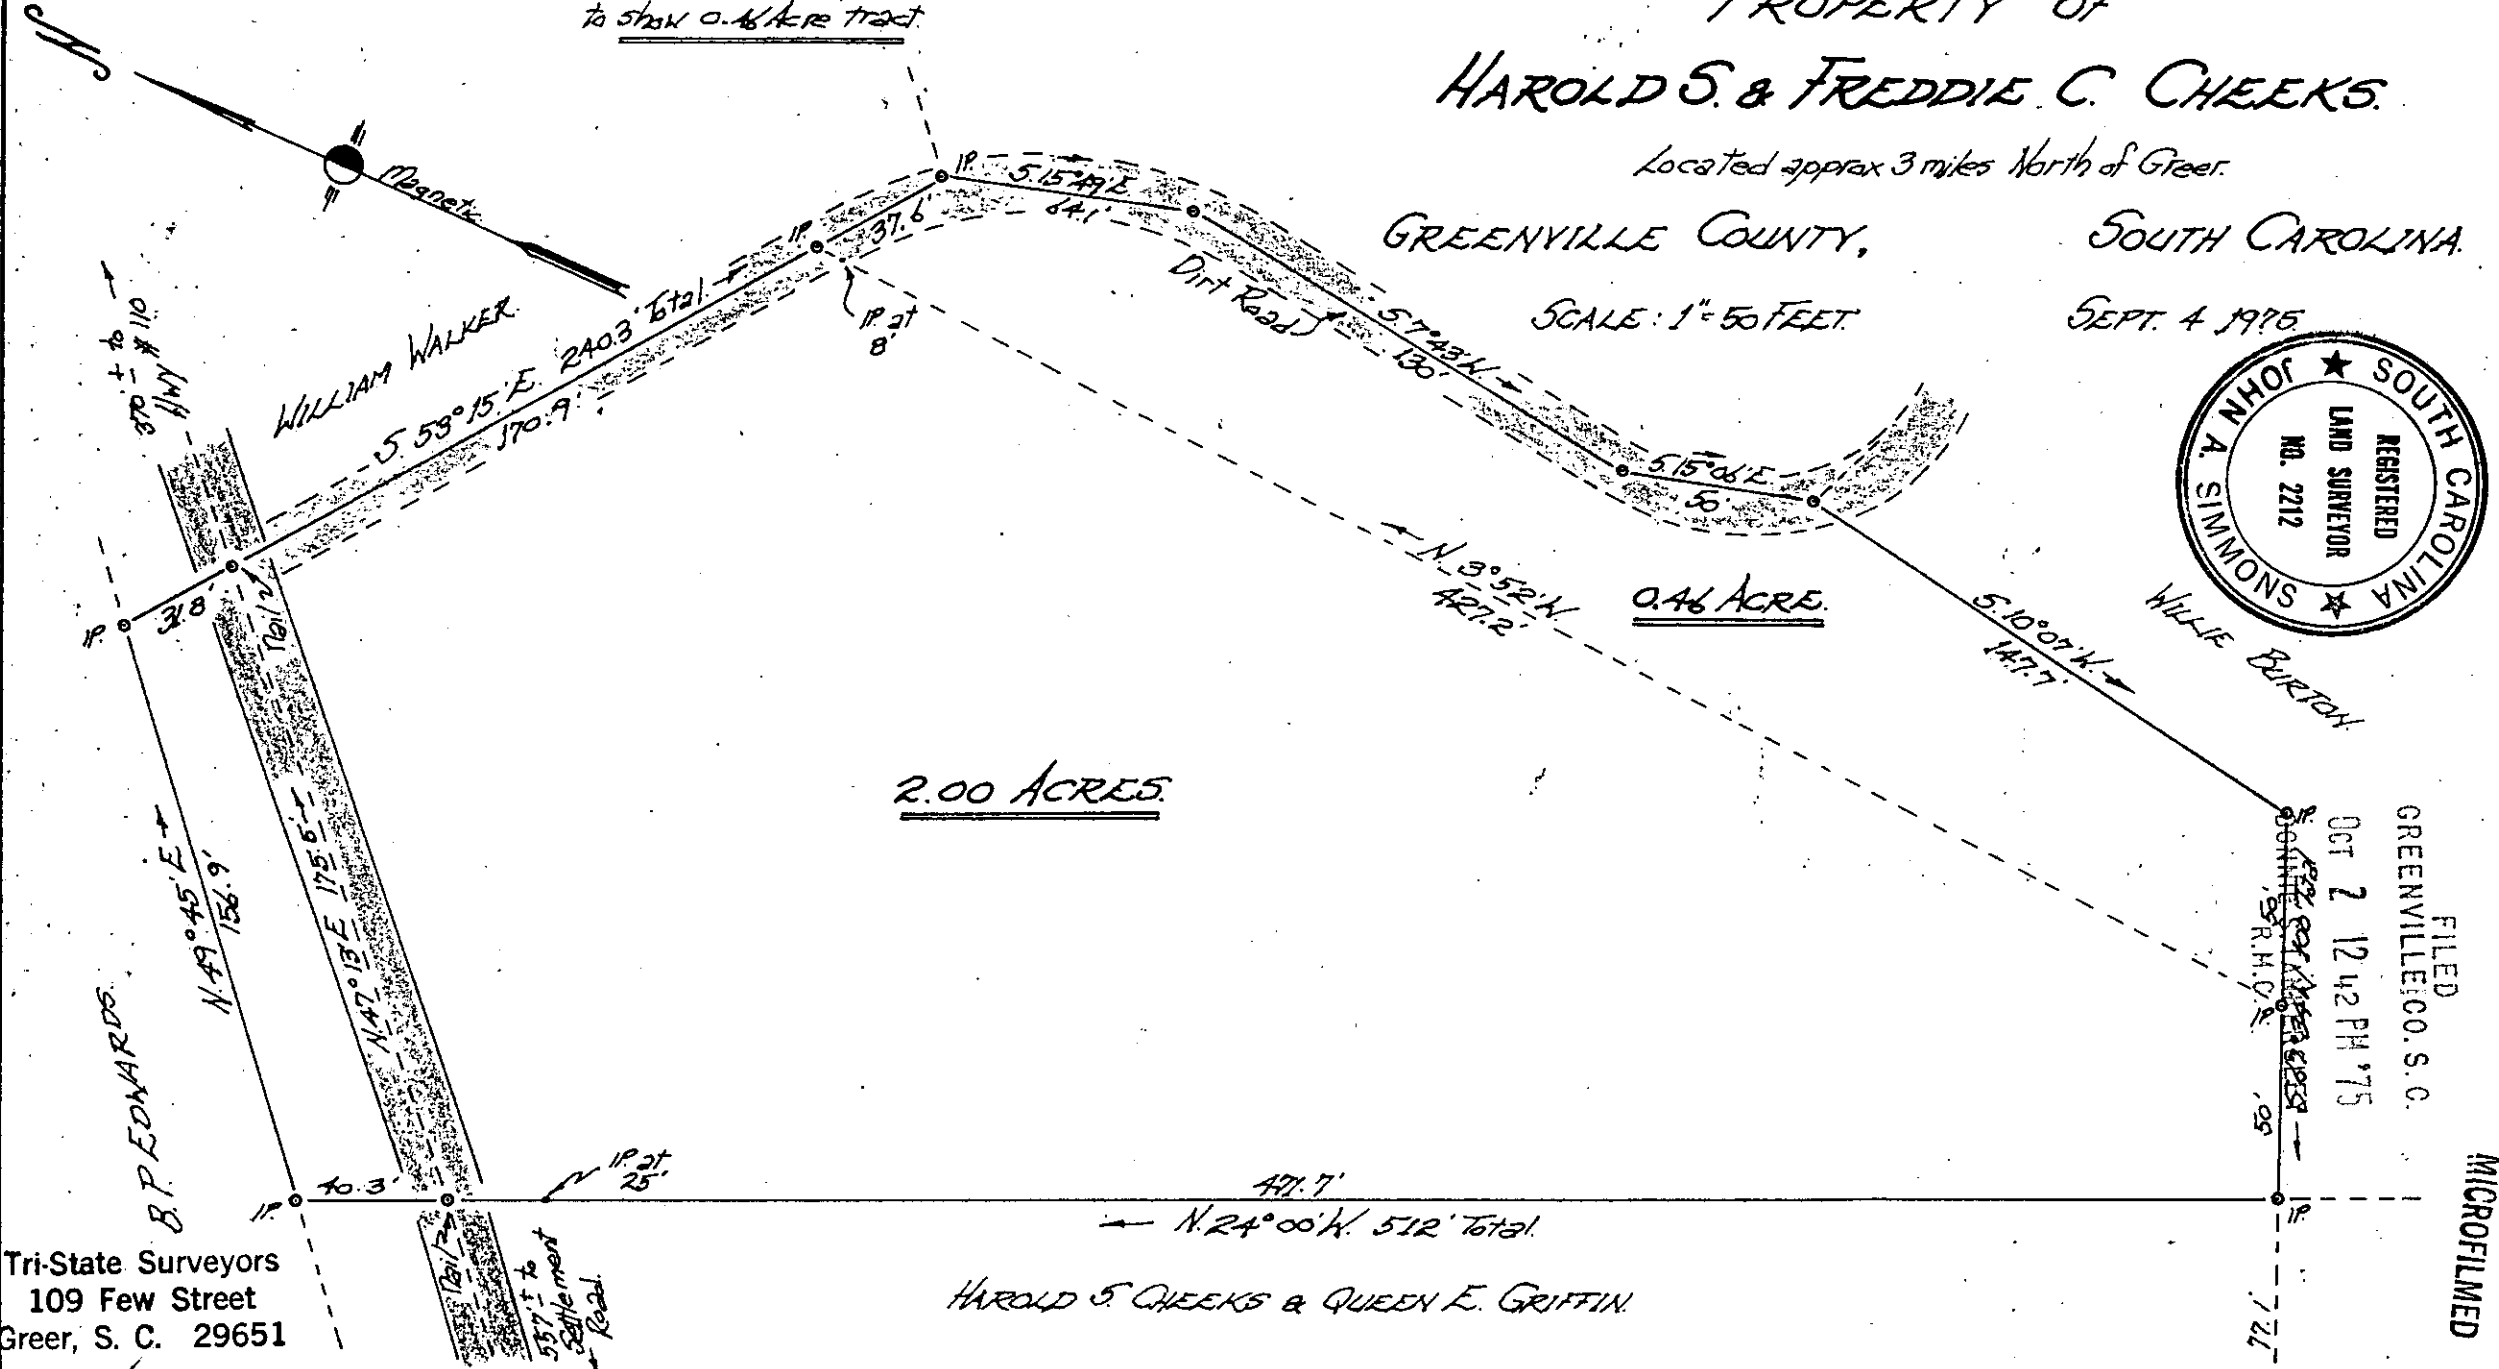

Tri-State Surveyors  
109 Few Street  
Greer, S. C. 29651

HAROLD S. CHEEKS & QUEEN E. GRIFFIN.

FILED  
GREENVILLE CO. S. C.  
OCT 2 12 42 PM '75

MICROFILMED

5 N - 54 8832

RECORDING: 1.00