
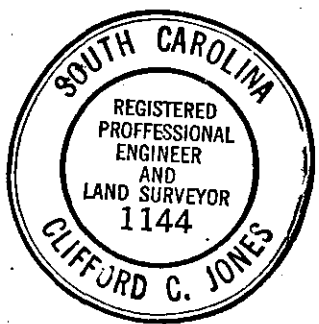


Oct 31 2 08 PM '75

DONNIE S. TANKERSLEY
R.M.C.

MICROFILMED

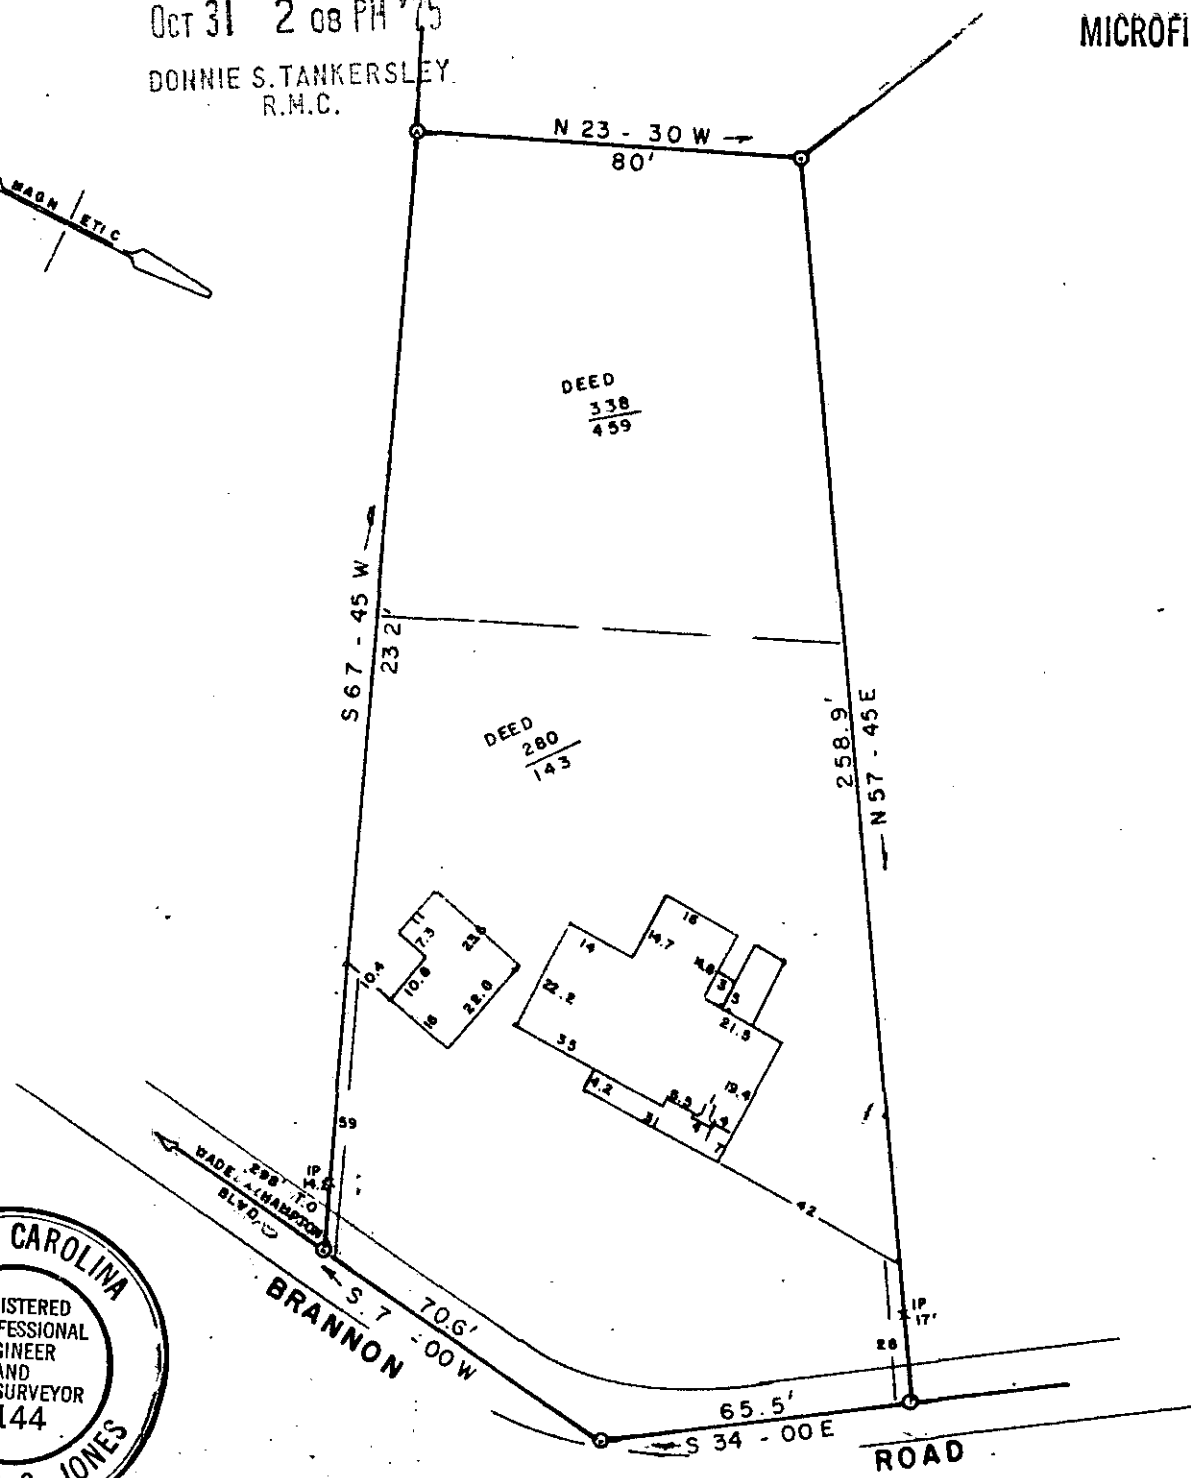

This is to certify that on the 28 day of OCT. 1975, I surveyed the property shown on this plat, being PT. LOT 4 I.B. BRANNON PROP., recorded in Plat Book of the R.M.C. Office for Greenville County, S. C., and that the property lines, walls and buildings are as shown hereon; that the buildings located on said lot do not encroach or project on adjacent streets or property; and that no adjacent buildings or walls encroach or project on said premises, and that no utility lines cross this property.

Clifford C. Jones
Reg. Engineer No. 1144 S.C.

JONES ENGINEERING SERVICE

OCT 31 1975

PROPERTY OF

11649
RECORDING FEE
PAID \$ 1.00

FRED DWAYNE CLAYTON

ROSE B. CLAYTON

GREENVILLE COUNTY, S. C.
SCALE 1" = 40' OCT. 28, 1975

1004 E. PERRY RD. 5N-102