

MICROFILMED


GREENVILLE, CO. S. C.
 Nov 13 1 13 PM '75
 DONNIE S. TANNERSLEY
 R.M.C.

EXCERPT OF
A. C. NELSON & MARY M. NELSON
 GREENVILLE, S. C.
 SCALE 1" = 40' 12 NOV 1975

This is to certify that on the 12th day of November 1975, I surveyed the property shown on this plat, being known as PROPERTY OF A. C. NELSON & MARY M. NELSON and recorded in the RMC Office Greenville County, S. C., in Plat Book at Page ; and that the property lines, walls and buildings are as shown hereon, and that the walls and buildings located on said lot do not encroach or project on adjacent street or property, and that no adjacent walls or buildings encroach or project on said premises, and no power lines cross this property except as shown hereon.

NOV 13 1975 12784
 ✓ 5N-109

R. B. Bruce
 R. B. Bruce, RLS #12784

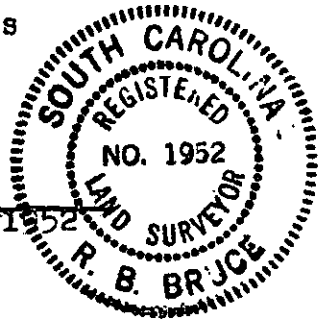

RECORDING FEE
 PAID \$ 1.00

CAROLINA SURVEYING CO.
 112 Manly St.
 Greenville, S. C.