


71600

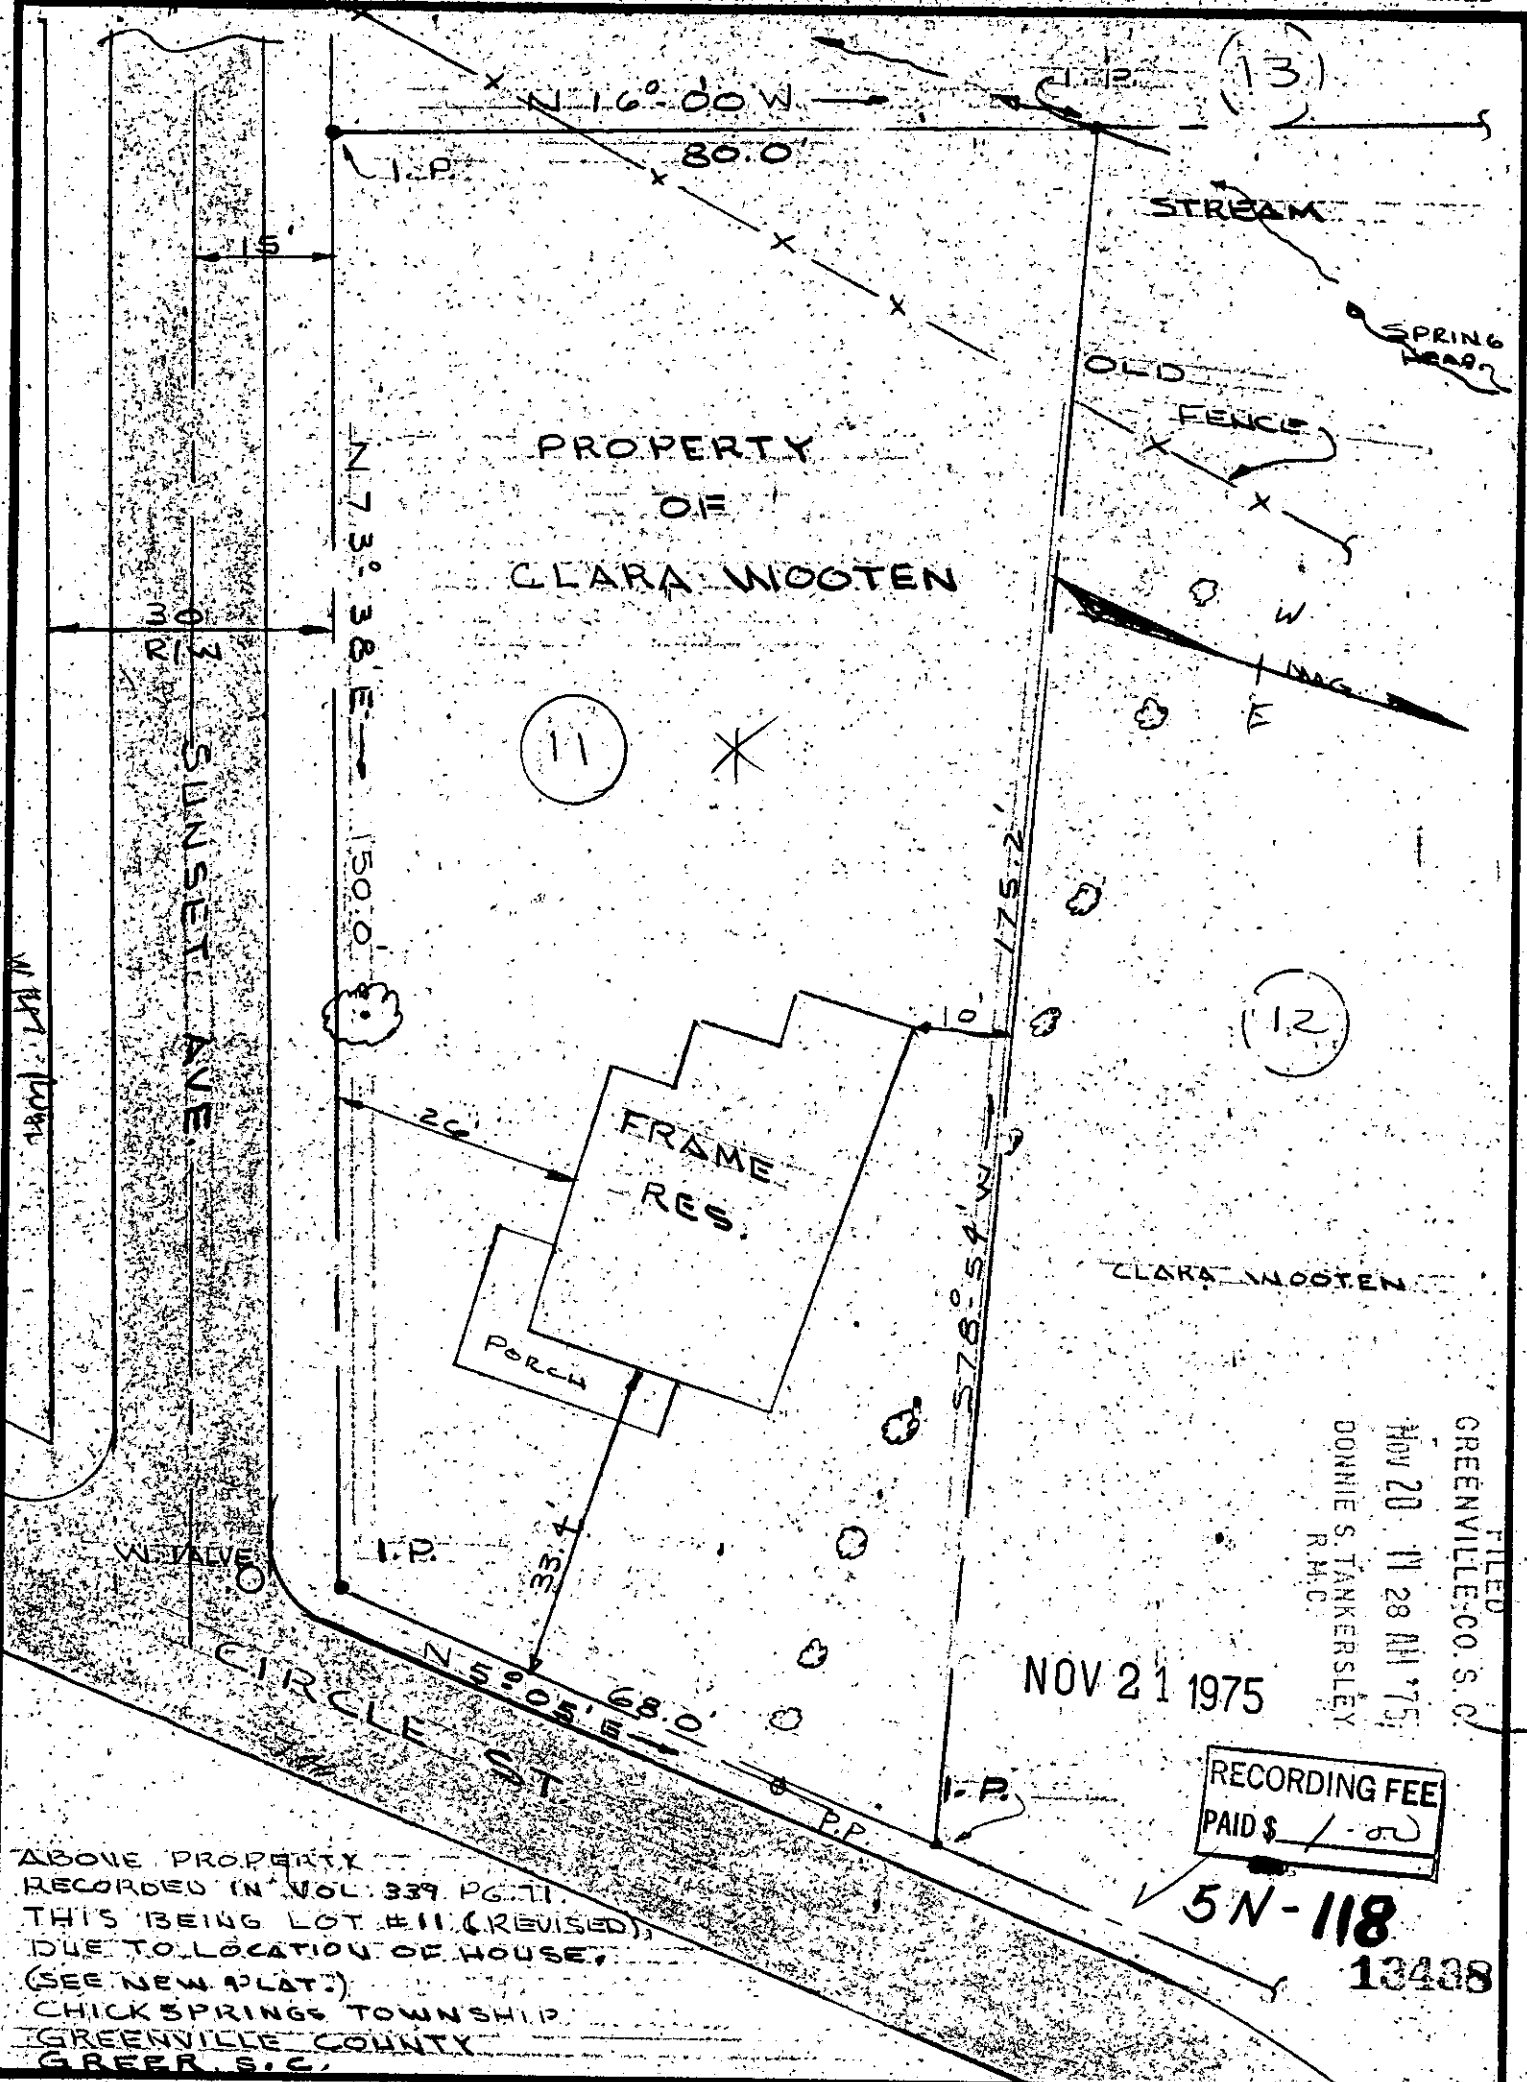

FILED
 GREENVILLE CO. S.C.
 NOV 20 11 28 AM '75
 DONNIE S. TANKERSLEY
 R.M.C.


NOV 21 1975

RECORDING FEE
 PAID \$ 1.00

5N-118
 13438

ABOVE PROPERTY RECORDED IN VOL. 339 PG. 11. THIS BEING LOT #11 (REVISED), DUE TO LOCATION OF HOUSE, (SEE NEW PLAT.) CHICK SPRINGS TOWNSHIP, GREENVILLE COUNTY, GREEN S.C.

Seal

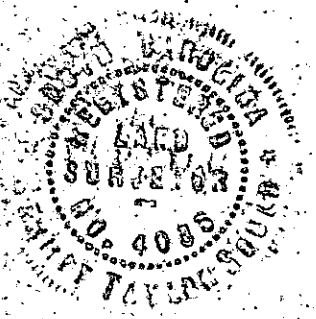

GOULD & ASSOCIATES
 LAND SURVEYORS
 TAYLORS S.C.

Drawn By K.T.G.
 Checked By
 Scale 1" = 20'
 Date 10-14-75
 File No. 10-7502