MICROFILMED

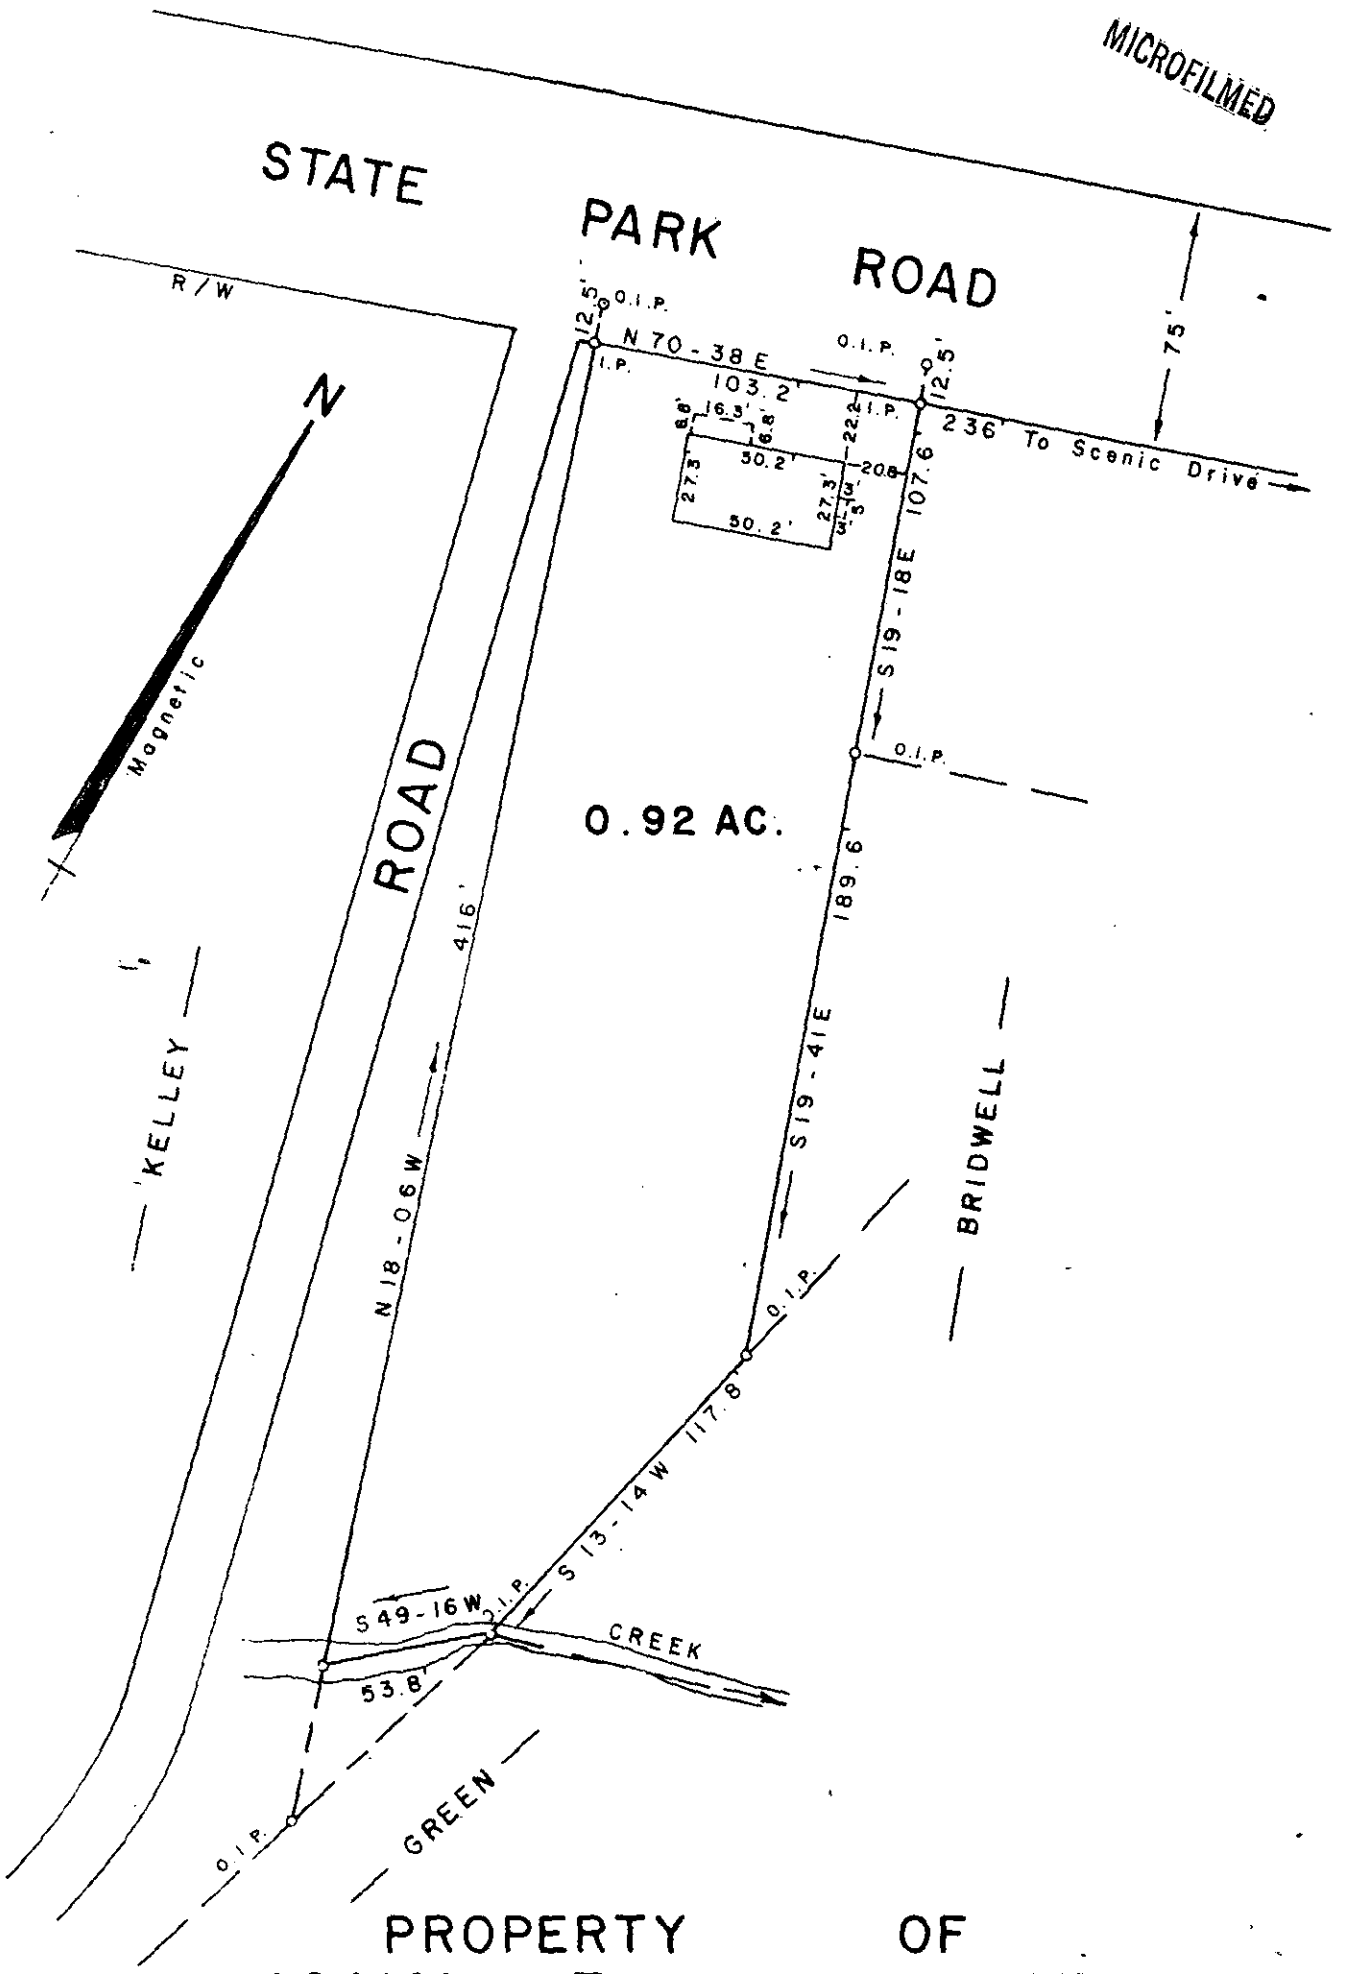

PROPERTY OF
JOHN R. SCAIFE
JOYCE E. SCAIFE

NEAR TRAVELERS REST GREENVILLE CO.

SOUTH CAROLINA

This is to certify that on the th day of March, 1976, I surveyed the property shown on this plat; and that the property lines, walls and buildings are as shown hereon; that the buildings located on said property do not encroach or project on adjacent streets property except as shown hereon; and that no adjacent buildings or walls encroach or project on said premises.

W. R. Williams, Jr.

W. R. WILLIAMS, JR. ENGR. / SURVEYOR # 3979

15 SOUTH MAIN STREET

TRAVELERS REST, S. C.

F.B. 14 492-1-17 SCALE 1" = 60'

SOUTH CAROLINA REGIS. PROF. ENGR. & LAND SURVEYOR W. R. WILLIAMS, JR.

FILED GREENVILLE CO. S.C. MAR 17 11 26 AM '76 DONNIE S. TANKERSLEY R.M.C.

RECORDING FEE PAID $ 2.00

MAR 17 1976

(2)

23612

5-0-63