FILED
GREENVILLE CO. S. C.
JAN 23 11 35 AM '76
DONNIE S. TANKERSLEY
R.M.C.

MICROFILMED

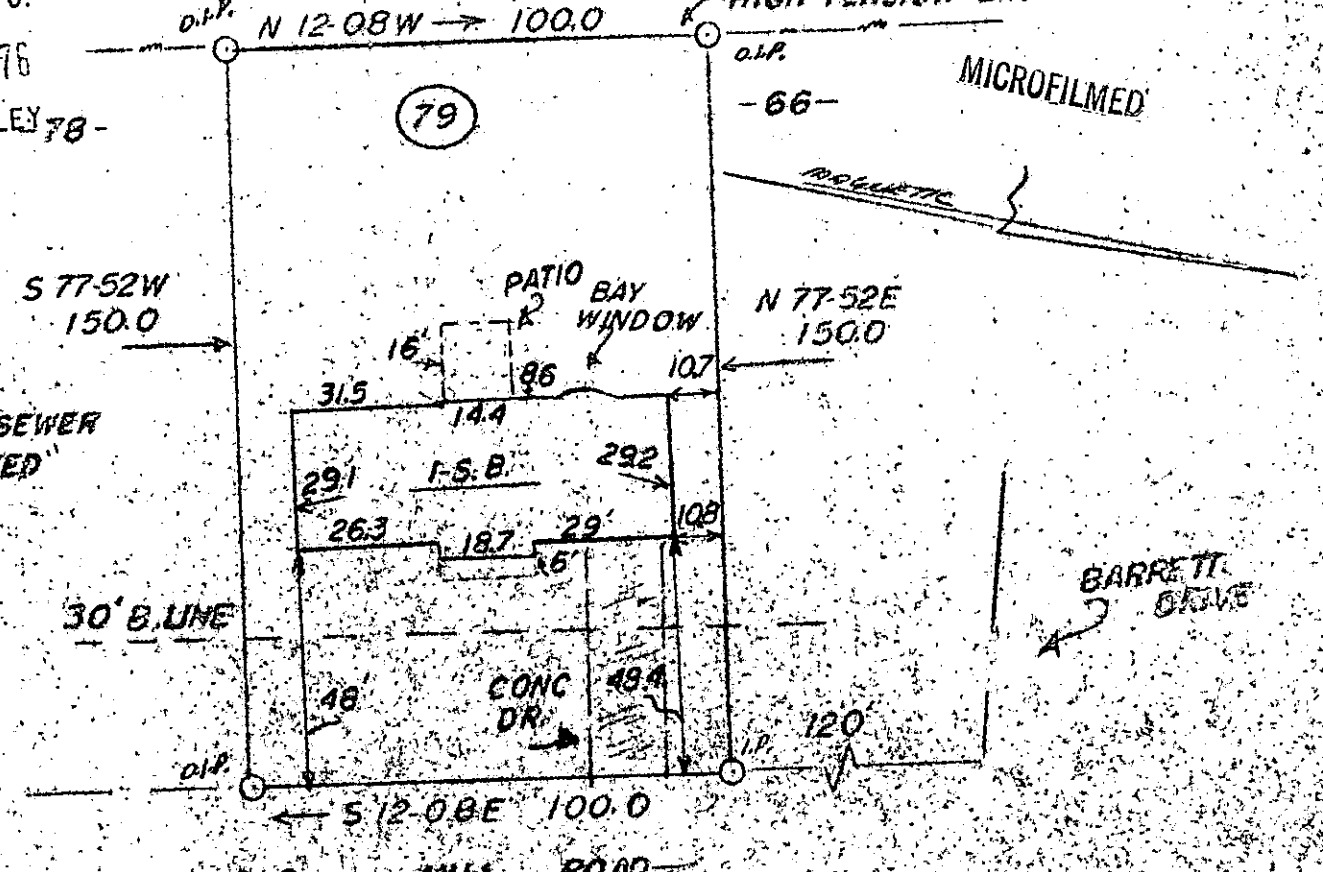

PROPERTY OF TIM V. & BELINDA S. BOVENDER

MAULDIN, S.C. SCALE 1=40' GREENVILLE COUNTY

THIS IS TO CERTIFY THAT ON THE 22ND DAY OF JANUARY, 1976, I SURVEYED THE PROPERTY SHOWN ON THIS PLAT, BEING KNOWN AS LOT 79 ON PLAT OF BURDETTE ESTATES, AND RECORDED IN THE R.M.C. OFFICE GREENVILLE COUNTY, S.C. IN PLAT BOOK 4X AT PAGE 60; AND THAT THE PROPERTY LINES, WALLS, BUILDINGS ARE AS SHOWN HEREON, AND THAT THE WALLS LOCATED ON SAID LOT DO NOT ENCROACH OR PROJECT ON ADJACENT STREETS OR PROPERTY, AND THAT NO ADJACENT WALLS OR BUILDINGS ENCROACH OR PROJECT ON SAID PREMISES, AND NO POWER LINES CROSS THE PROPERTY EXCEPT AS SHOWN HEREON.

J. L. MONTGOMERY, III
REG. PROF. SURVEYOR

SOUTH CAROLINA REGISTERED LAND SURVEYOR NO. 4552

18721
JAN 23 1976

RECORDING FEE
PAID $ 1.00

5Q-4