



WEST WING EAST WING  
**UPPER LEVEL FLOOR PLAN**  
 1/8" SCALE

- NOTES:**
- The plans shown on this drawing consists of two bedroom units.
  - Each unit consists of the space bounded by the undercoated and/or unfinished surfaces of the floors, ceilings, and perimeter or load bearing walls, except with respect to the walls between the adjacent units, the vertical boundary line of each unit shall be the center of the party wall.
  - All interior and exterior angles are 90 degrees unless otherwise noted.
  - Unless otherwise noted all areas other than units and limited common elements are to be considered common elements.

**LEGEND**  
 ——— BOUNDARY OF UNIT

**ARCHITECTS CERTIFICATION**  
 I, Joe W. Miller, do hereby certify that this plan fully depicts within reasonable construction tolerances the layout, location, number, letter identifications, and dimensions of the buildings and dwellings contained therein.

DATE: AUG. 20 1976  
*Joe W. Miller*

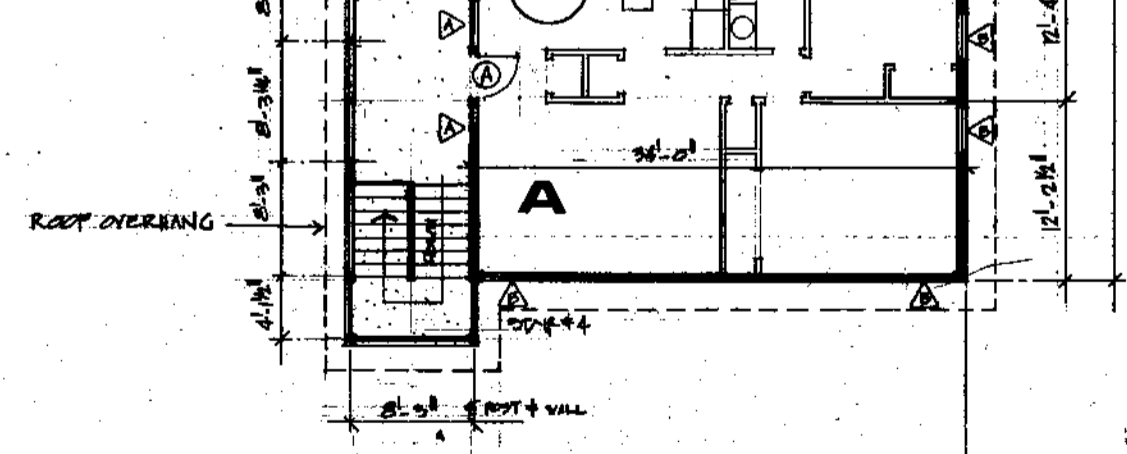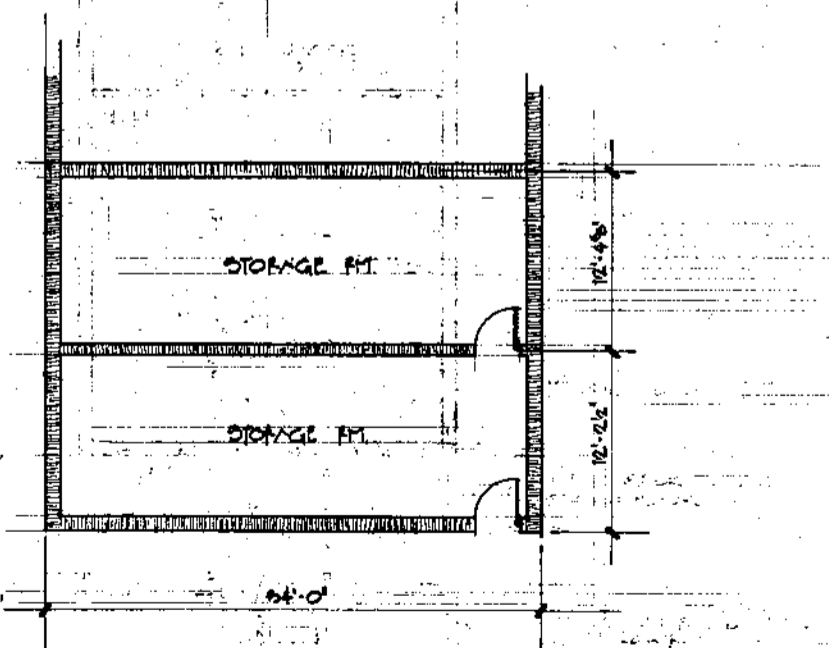

MIDDLETON PLACE  
 HORIZONTAL PROPERTY REGIME  
 FLOOR PLANS

EXHIBIT B  
 SHEET 3 of 4

LOWER LEVEL STORAGE PLANS 1/8" - 1-d  
 UNDER UNIT B.15

AUG 27 1976  
 #5670  
 5-R-87C

RECORDING FEE  
 PAID \$ 3.00