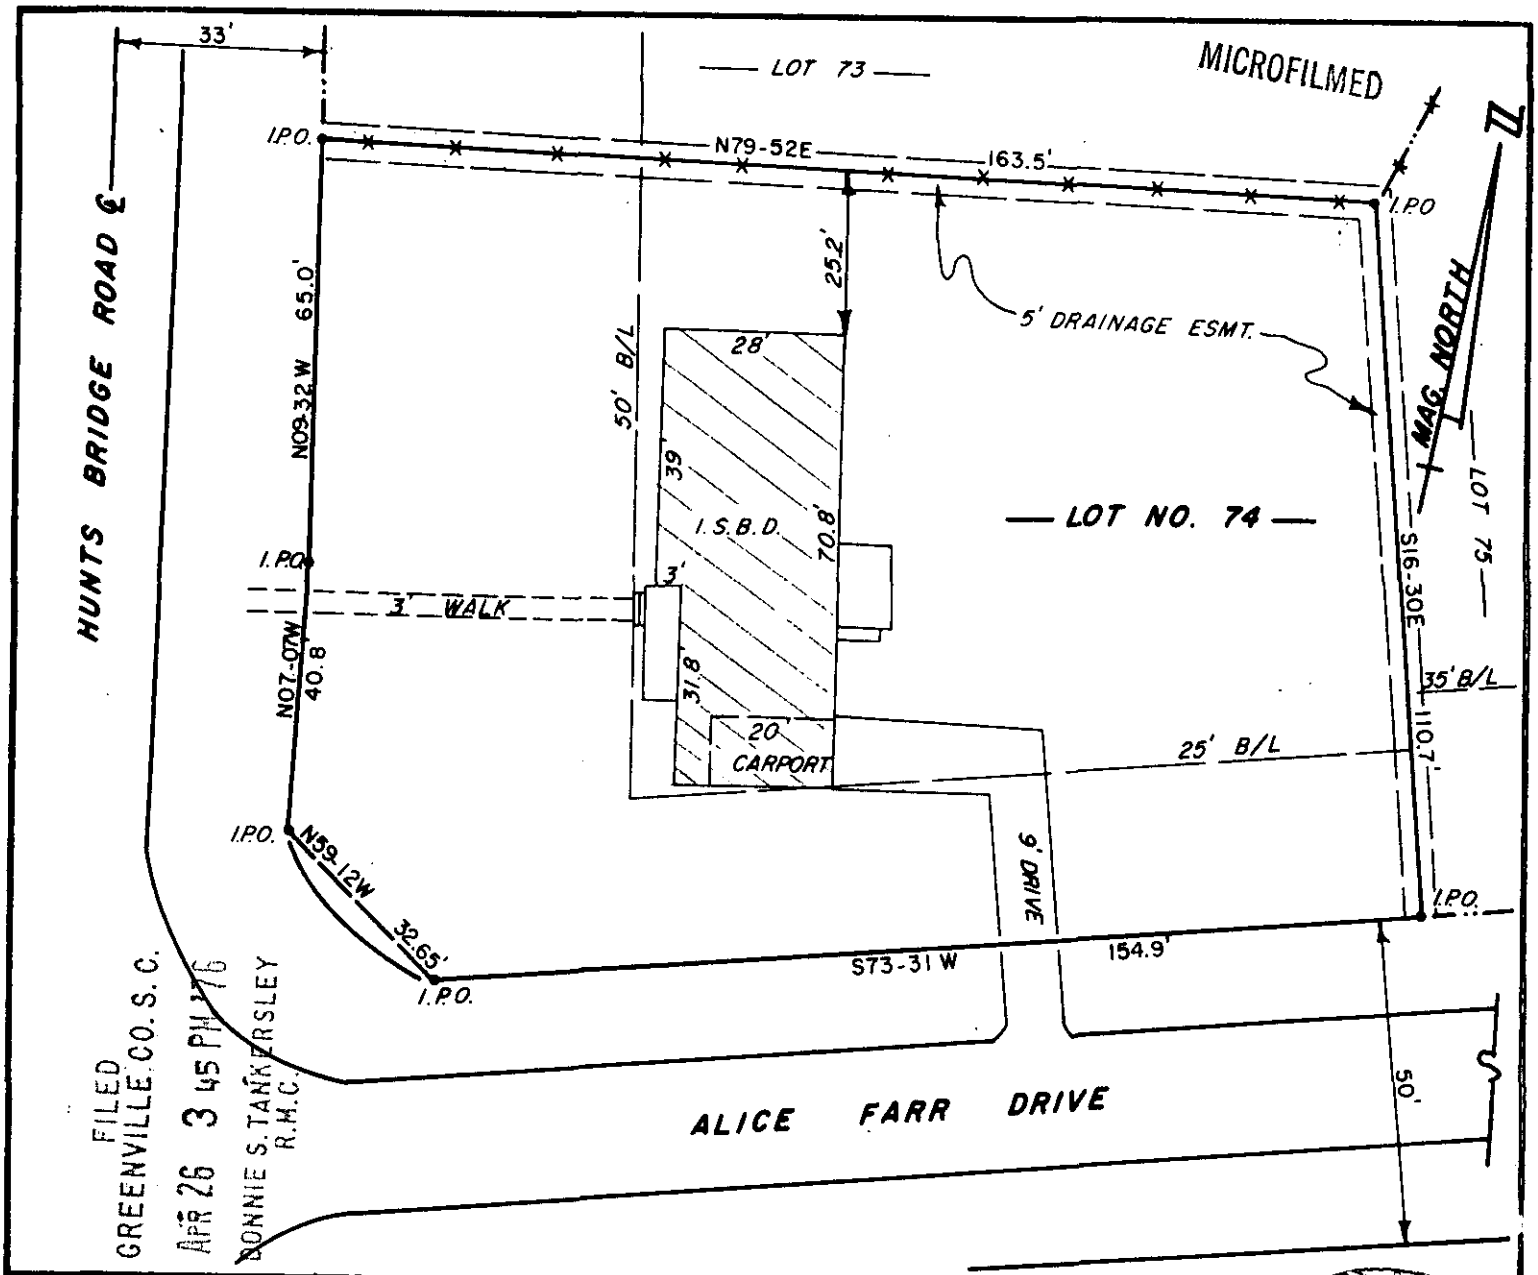

THIS IS TO CERTIFY THAT ON THE 21st DAY OF APRIL, 1976 I DID SURVEY THE ABOVE SHOWN LOT. THE SAME BEING KNOWN AND DESIGNATED AS LOT NO. 74 OF "WESTERN HILLS". AS SHOWN BY A PLAT RECORDED IN THE CLERK OF COURTS OFFICE FOR GREENVILLE COUNTY IN PLAT BOOK QQ AT PAGE 98-99. I FUTHER CERTIFY THAT THE PROPERTY LINES, STREETS, AND IMPROVEMENTS ARE AS SHOWN ABOVE AND THAT THERE ARE NO ENCROACHMENTS.

SOUTH CAROLINA REGISTERED No. 3615 LAND SURVEYOR ROBERT R. SPEARMAN

✓5-S-44

27572

RECORDING FEE
PAID $ 1.00

ROBERT R. SPEARMAN R.L.S.NO.3615

ROBERT R. SPEARMAN
Registered Surveyor 3615
Post Office Box 6
Easley, South Carolina 29640

TITLE
PROPERTY OF-WALTER R. ROBERTSON
& DONNA W. ROBERTSON
409 HUNTS BRIDGE ROAD
GREENVILLE, S.C.

STATE	COUNTY	
S.C.	GREENVILLE	
SCALE	DATE	REF. NO.
1" = 30'	APR. 20, 1976	