MAY 27 3 53 PM '76
DONNIE S. TANKERSLEY
R.M.C.

MICROFILMED

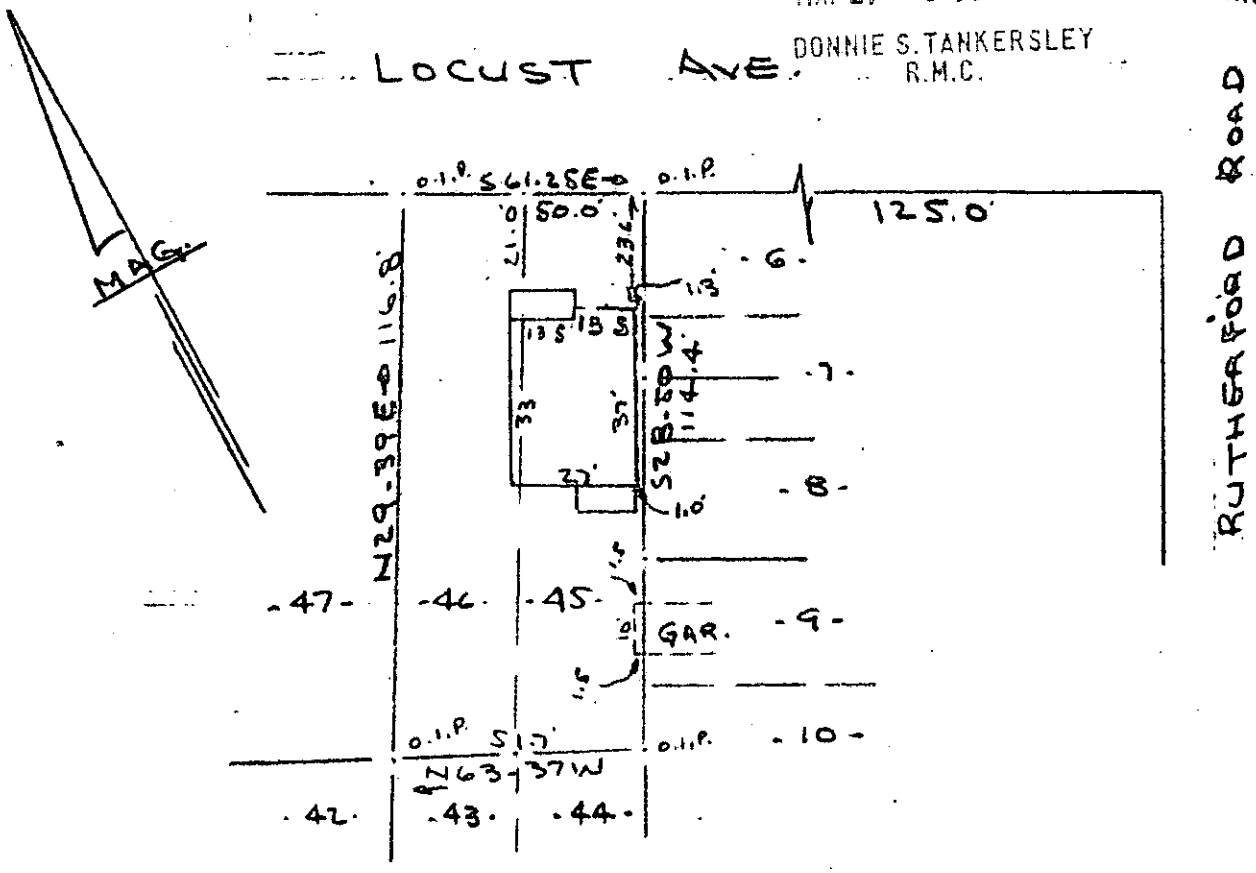

SURVEY FOR
ALICE PATTERSON PEPPER
NEAR GREENVILLE, S.C.
SCALE 1" = 40' 27 MAY 1976

This is to certify that on the 27th day of May 1976, I surveyed the property shown on this plat, being known as lot 45 & 46 on plat of OAKLAWN and recorded in the RMC Office Greenville County, S. C., in Plat Book " E" at Page 273.

R. B. Bruce

R. B. Bruce, RLS #1952

SOUTH CAROLINA REGISTERED Land Surveyor R. B. BRUCE

5-S-95

MAY 27 '76 30796

RECORDING FEE
PAID $ 1.00

CAROLINA SURVEYING CO.
112 Manly St.
Greenville, S. C.

180-39 181-69