
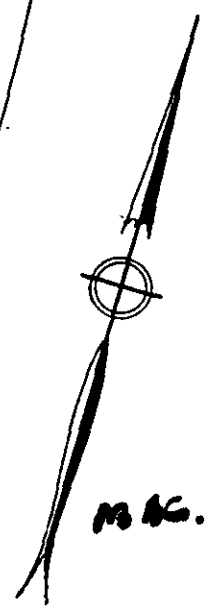


MICROFILMED

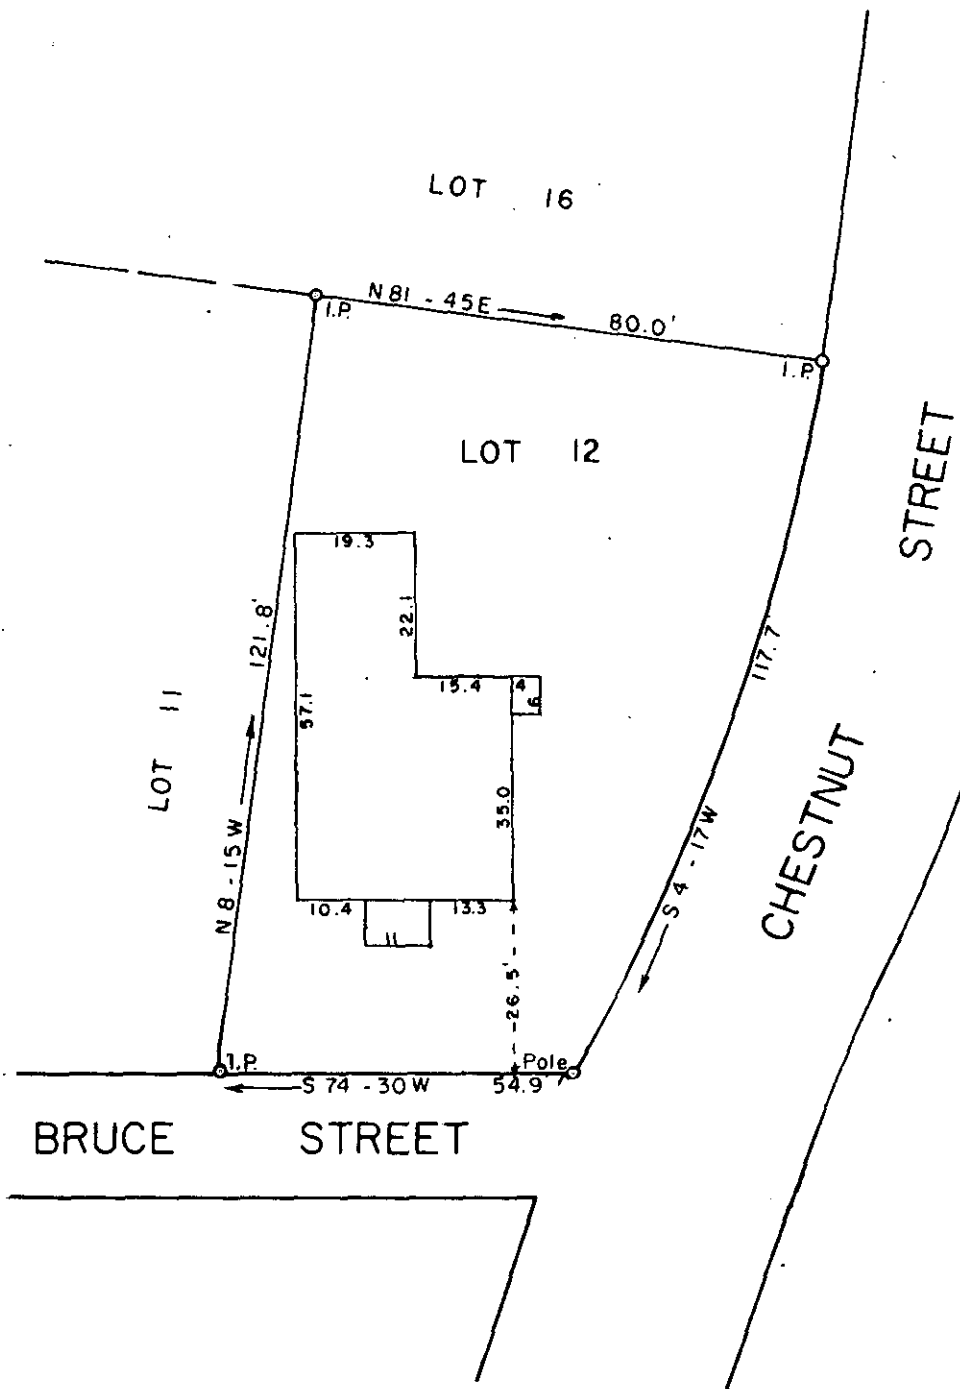


FILED
 GREENVILLE CO. S. C.
 AUG 26 3 14 PM '76
 DONNIE S. TANKERSLEY
 R.M.C.

PROPERTY OF
 CHARLES ANDREW GOLDSMITH
 DELLA LOUISE JOHNSON GOLDSMITH
 GREENVILLE, S. C.

Scale 1" = 30' August, 1976

This is to certify that on the 20th day of August, 1976, we surveyed the property shown on this plat; being known as Lot 12 on plat of W. B. McDowell, Recorded in Plat Book S at page 53, Office of the R.M.C. for Greenville County, South Carolina; and that the property lines, walls and buildings are as shown hereon; that the buildings located on said lot do not encroach or project on adjacent streets or property; and that no adjacent buildings or walls encroach or project on said premises.

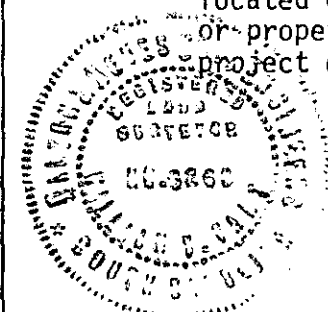

5526

William B. Fant
 DALTON & NEVES CO., ENGINEERS.

RECORDING FEE
 \$ 2.00

✓ 5T-63

S.C. Reg. 6266
 F.B. 417