


68 DUKE POWER TRANSMISSION LINE  
 H.C. ...  
 N4 ...

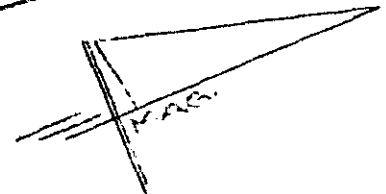

MICROFILMED

- W. T. MARTIN -

N67.05 W  
 435.9'

SEPTIC TANK ON LOT

- BERRY -

PROPERTY OF

TOMMY L. RALSTON  
 BARBARA J. RALSTON  
 NEAR GREENVILLE, S. C.

WELL

SEWER

435.1  
 567.0 SE

110  
 543.58 W  
 RAINIER

ROAD

FILED  
 GREENVILLE CO. S. C.  
 JUN 1 10 44 AM '76  
 DONNIE S. TANKERSLEY  
 R.M.C.

This is to certify that on the 28th day of May 1976, I surveyed the property shown on this plat, being known as PROPERTY OF TOMMY L. RALSTON & BARBARA J. RALSTON and recorded in the RMC Office Greenville County, S. C., in Plat Book at Page ; and that the property lines, walls and buildings are as shown hereon, and that the walls and buildings located on said property do not encroach or project on adjacent street or property, and that no adjacent walls or buildings encroach or project on said premises, and no power lines cross this property except as shown hereon.

*R. B. Bruce*  
 R. B. Bruce, RLS #1952

CAROLINA SURVEYING CO. REGISTERED 1976  
 RECORDING  
 PAID \$

CAROLINA SURVEYING CO. 31057  
 112 Manly St.  
 Greenville, S. C.  
 5-4-1