

MICROFILMED

TRYON AVE.

HALL ROAD


FILED  
GREENVILLE, CO. S. C.  
JUL 15 10 35 AM '76  
DONNIE S. TANKERSLEY  
R.M.C.

This is to certify that on July 2, 1976, I surveyed the property shown on this plat, known as Lot on Hall Road on plat of the Sue Hall Kelley Property, filed in the R.M.C. Office of Greenville County in Plat Book NNN on Page 103, and that the property lines, walls and buildings are as shown hereon; that the building located on said lot does not encroach or project on adjacent streets or property, and that no adjacent walls or buildings encroach or project on said premises, and that no utility lines cross this property except as shown hereon.

15-4-96

1393

*James R. Freeland*  
James R. Freeland R.L.S. 4781

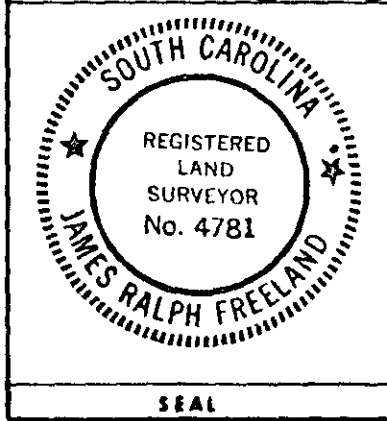

**STATE OF SOUTH CAROLINA  
GREENVILLE COUNTY**

PROPERTY OF  
**JAY ALLEN GUEST**

JUL 15 1976

FREELAND & ASSOCIATES.  
Engineers • Land Surveyors  
GREENVILLE, S. C.

SURVEY D.G.  
DRAWN F.L.  
CHECK J.F.  
SCALE 1" = 50'  
DATE 7-6-76  
DWG. NO. 76-1033

RECORDING FEE  
PAID \$ 1.00

SEAL