


FILED
GREENVILLE CO. S. C.

OCT 29 3 07 PM '76

DONNIE S. TANKERSLEY
R.M.C.

MICROFILMED

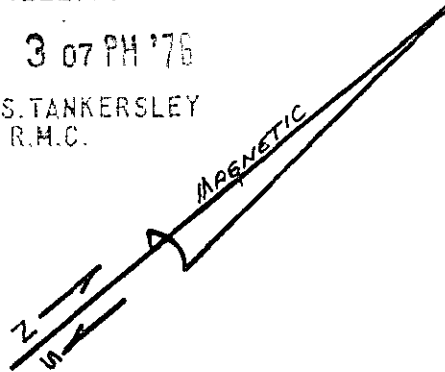

9 1 28 29M

1.00 AS

PROPERTY OF
BOBBIE JEAN MURRAY
GREENVILLE, SOUTH CAROLINA
SCALE 1" = 40' OCT 29, 1976

This is to certify that on October 29, 1976, I surveyed the property shown on this plat, known as Lot No. 44 of Isaqueena Park as shown on a plat recorded in the RMC Office for Greenville Co. in Plat Book P at page 131, and that the property lines, walls and building are as shown hereon, and that the building located on said lot does not project nor encroach on adjacent street or property, and that no adjacent walls or buildings project nor encroach on said lot, and that no utility lines cross this lot except as may be shown hereon.

11895

Survey by Campbell & Clarkson
Surveyors, Inc.

15-W-61

OCT 29 '76

R. D. ...
S. C. R. L. S. No. 4678

DM