
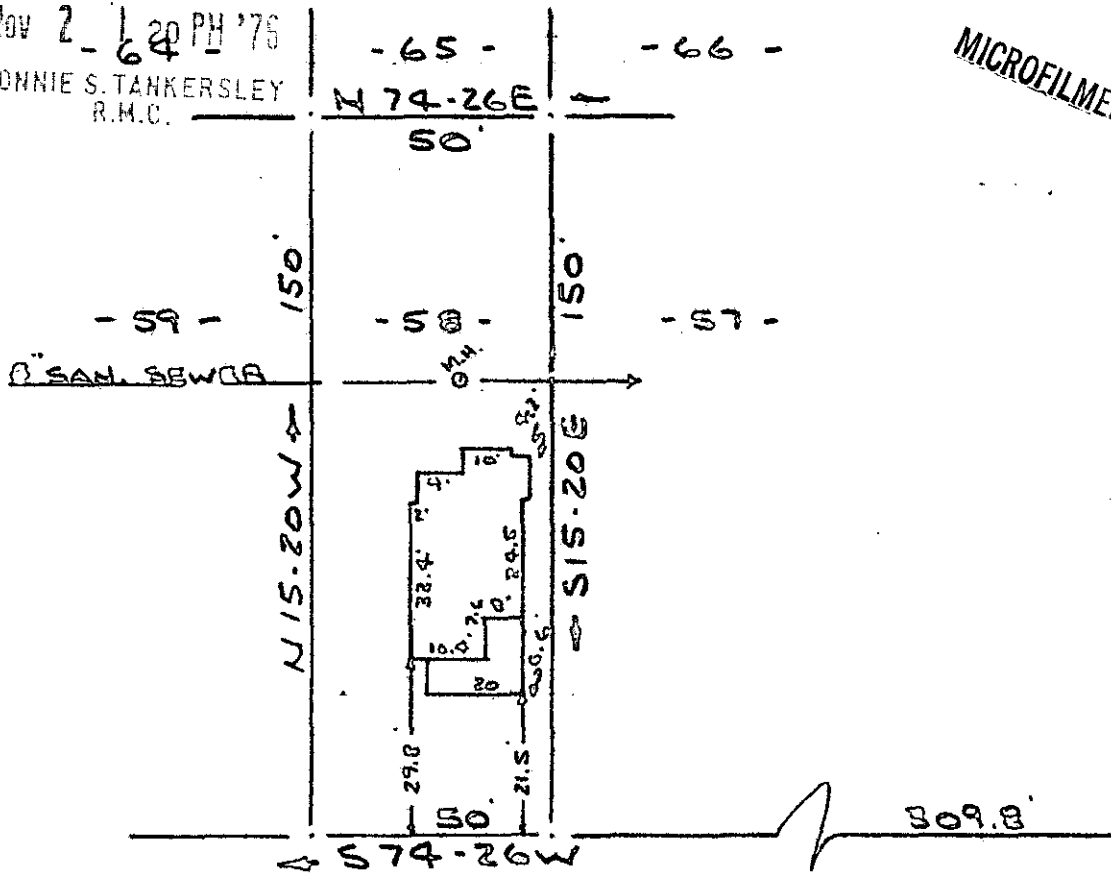


FILED
GREENVILLE, CO. S. C.

Nov 2 - 1 20 PM '76
DONNIE S. TANKERSLEY
R.M.C.

NOTE: Improvements on this lot are not in a flood hazard area.

MICROFILMED

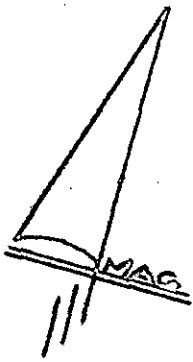

PENDLETON ROAD
WATER & SEWER IN ST. R/W

PROPERTY OF
JOEL THERON CENTER & KATHLEEN CENTER
GREENVILLE, SOUTH CAROLINA
SCALE 1" = 40' NOV 1976

This is to certify that on the 1st day of November 1976, I surveyed the property shown on this plat, being known as lot 58 on plat of DONWOOD and recorded in the RMC Office Greenville County, S. C., in Plat Book " A " at Pages 462 & 463; and that the property lines, walls and buildings are as shown hereon, and that the walls and buildings located on said lot do not encroach or project on adjacent street or property, and that no adjacent walls or buildings encroach or project on said premises, and no power lines cross this property except as shown hereon.

12147

R. B. Bruce

R. B. Bruce, RLS #1952

5w-63

CAROLINA SURVEYING CO.
112 Manly St.
Greenville, S. C.

NOV 2 1976

RE 12147-6-9
1.00 AS