MICROFILMED

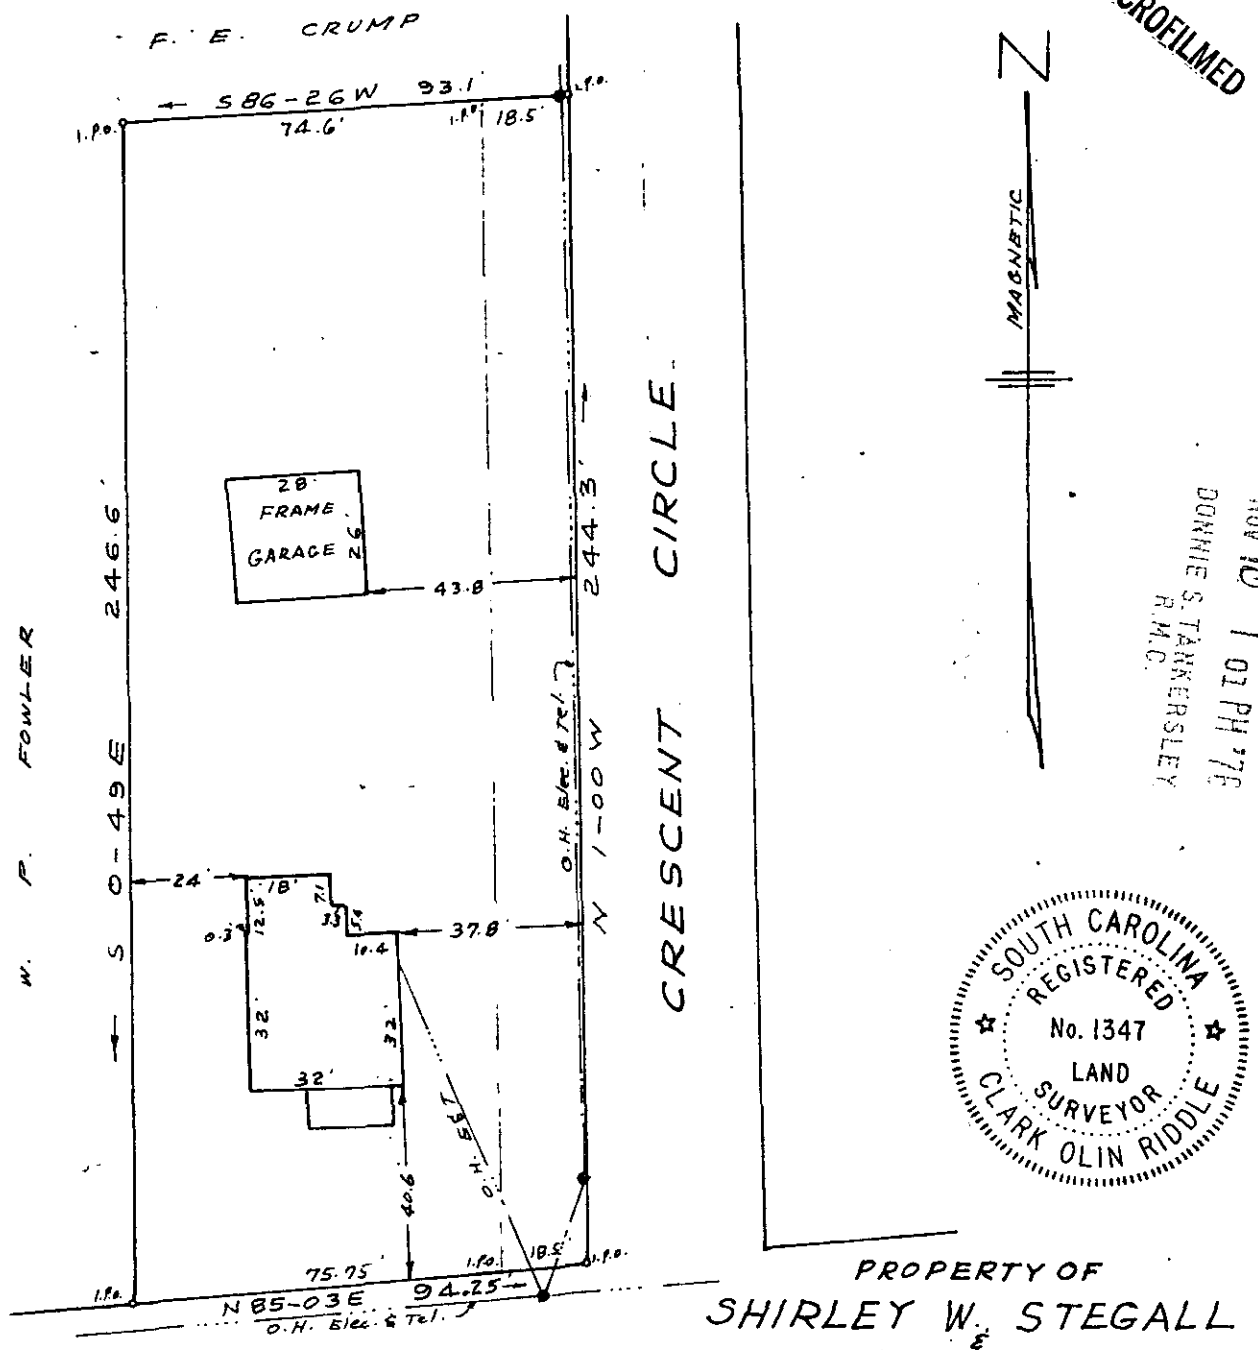

FILED GREENVILLE CO. S.C.
NOV 10 1 01 PM '76
DONNIE S. TANKERSLEY R.M.C.

✓5-W-83

This is to certify that on the 28th. day of September, 1976, I surveyed the above lot, shown as plat of property of Daniel E. Stegall said plat recorded in plat book page Greenville County R. M. C., and that the property lines, walls and buildings are as shown hereon; that the buildings located on said property do not encroach or project on adjacent streets or property, and that no adjacent walls, buildings or power lines encroach or project on said premises except as shown hereon, and that the property is not in a flood prone area.

NOV 10 '76

C. O. Riddle - Reg. L.S. 1347 - Greenville, S.C.

3 3 5 2 NOV 10 C 1.00 A4