


FILED
 GREENVILLE CO. S. C.
 JAN 20 9 52 AM '77
 BONNIE S. TANKERSLEY
 R.M.C.

MICROFILME.

- LEGEND**
- ⊕ LIGHTS ON METAL POLE IN 18'x18' CONC. BASE
 - ⊙ LIGHT ON METAL POLE
 - ⊛ POWER, TEL. OR GUY POLE
 - ⊠ CATCH BASIN & PIPE (STORM SEWER)
 - ⊞ POWER VAULT
 - → MANHOLE & SAN. SEWER LINE

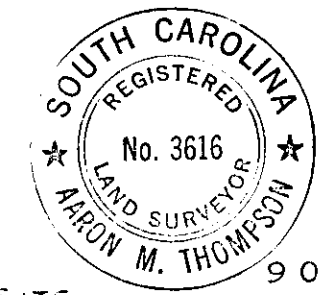

I CERTIFY THE ABOVE SURVEY TO BE CORRECT.

Aron M. Thompson R.L.S. No. 3616
 3.00 M

SURVEY FOR
THE PRUDENTIAL INSURANCE COMPANY OF AMERICA
 GREENVILLE COUNTY, SOUTH CAROLINA
 SCALE 1" = 50' - DECEMBER 28, 1976

19883
 5X-56 ✓
 JAN 20 '77
 PIEDMONT ENGINEERS - ARCHITECTS - PLANNERS
 GREENVILLE, S. C.

NOTE
 FOR LOCATION OF UNDERGROUND UTILITIES ON SITE SUCH AS POWER, TEL., & GAS ETC. CONTACT UTILITY COMPANIES