


MICROFILMED

PROPERTY OF
LAWRENCE FRANK
FLORENCE C. FRANK
GROVE TOWNSHIP GREENVILLE CO.
SOUTH CAROLINA
AUGUST 4, 1975
REVISED AUGUST 13, 1976 (LOT)

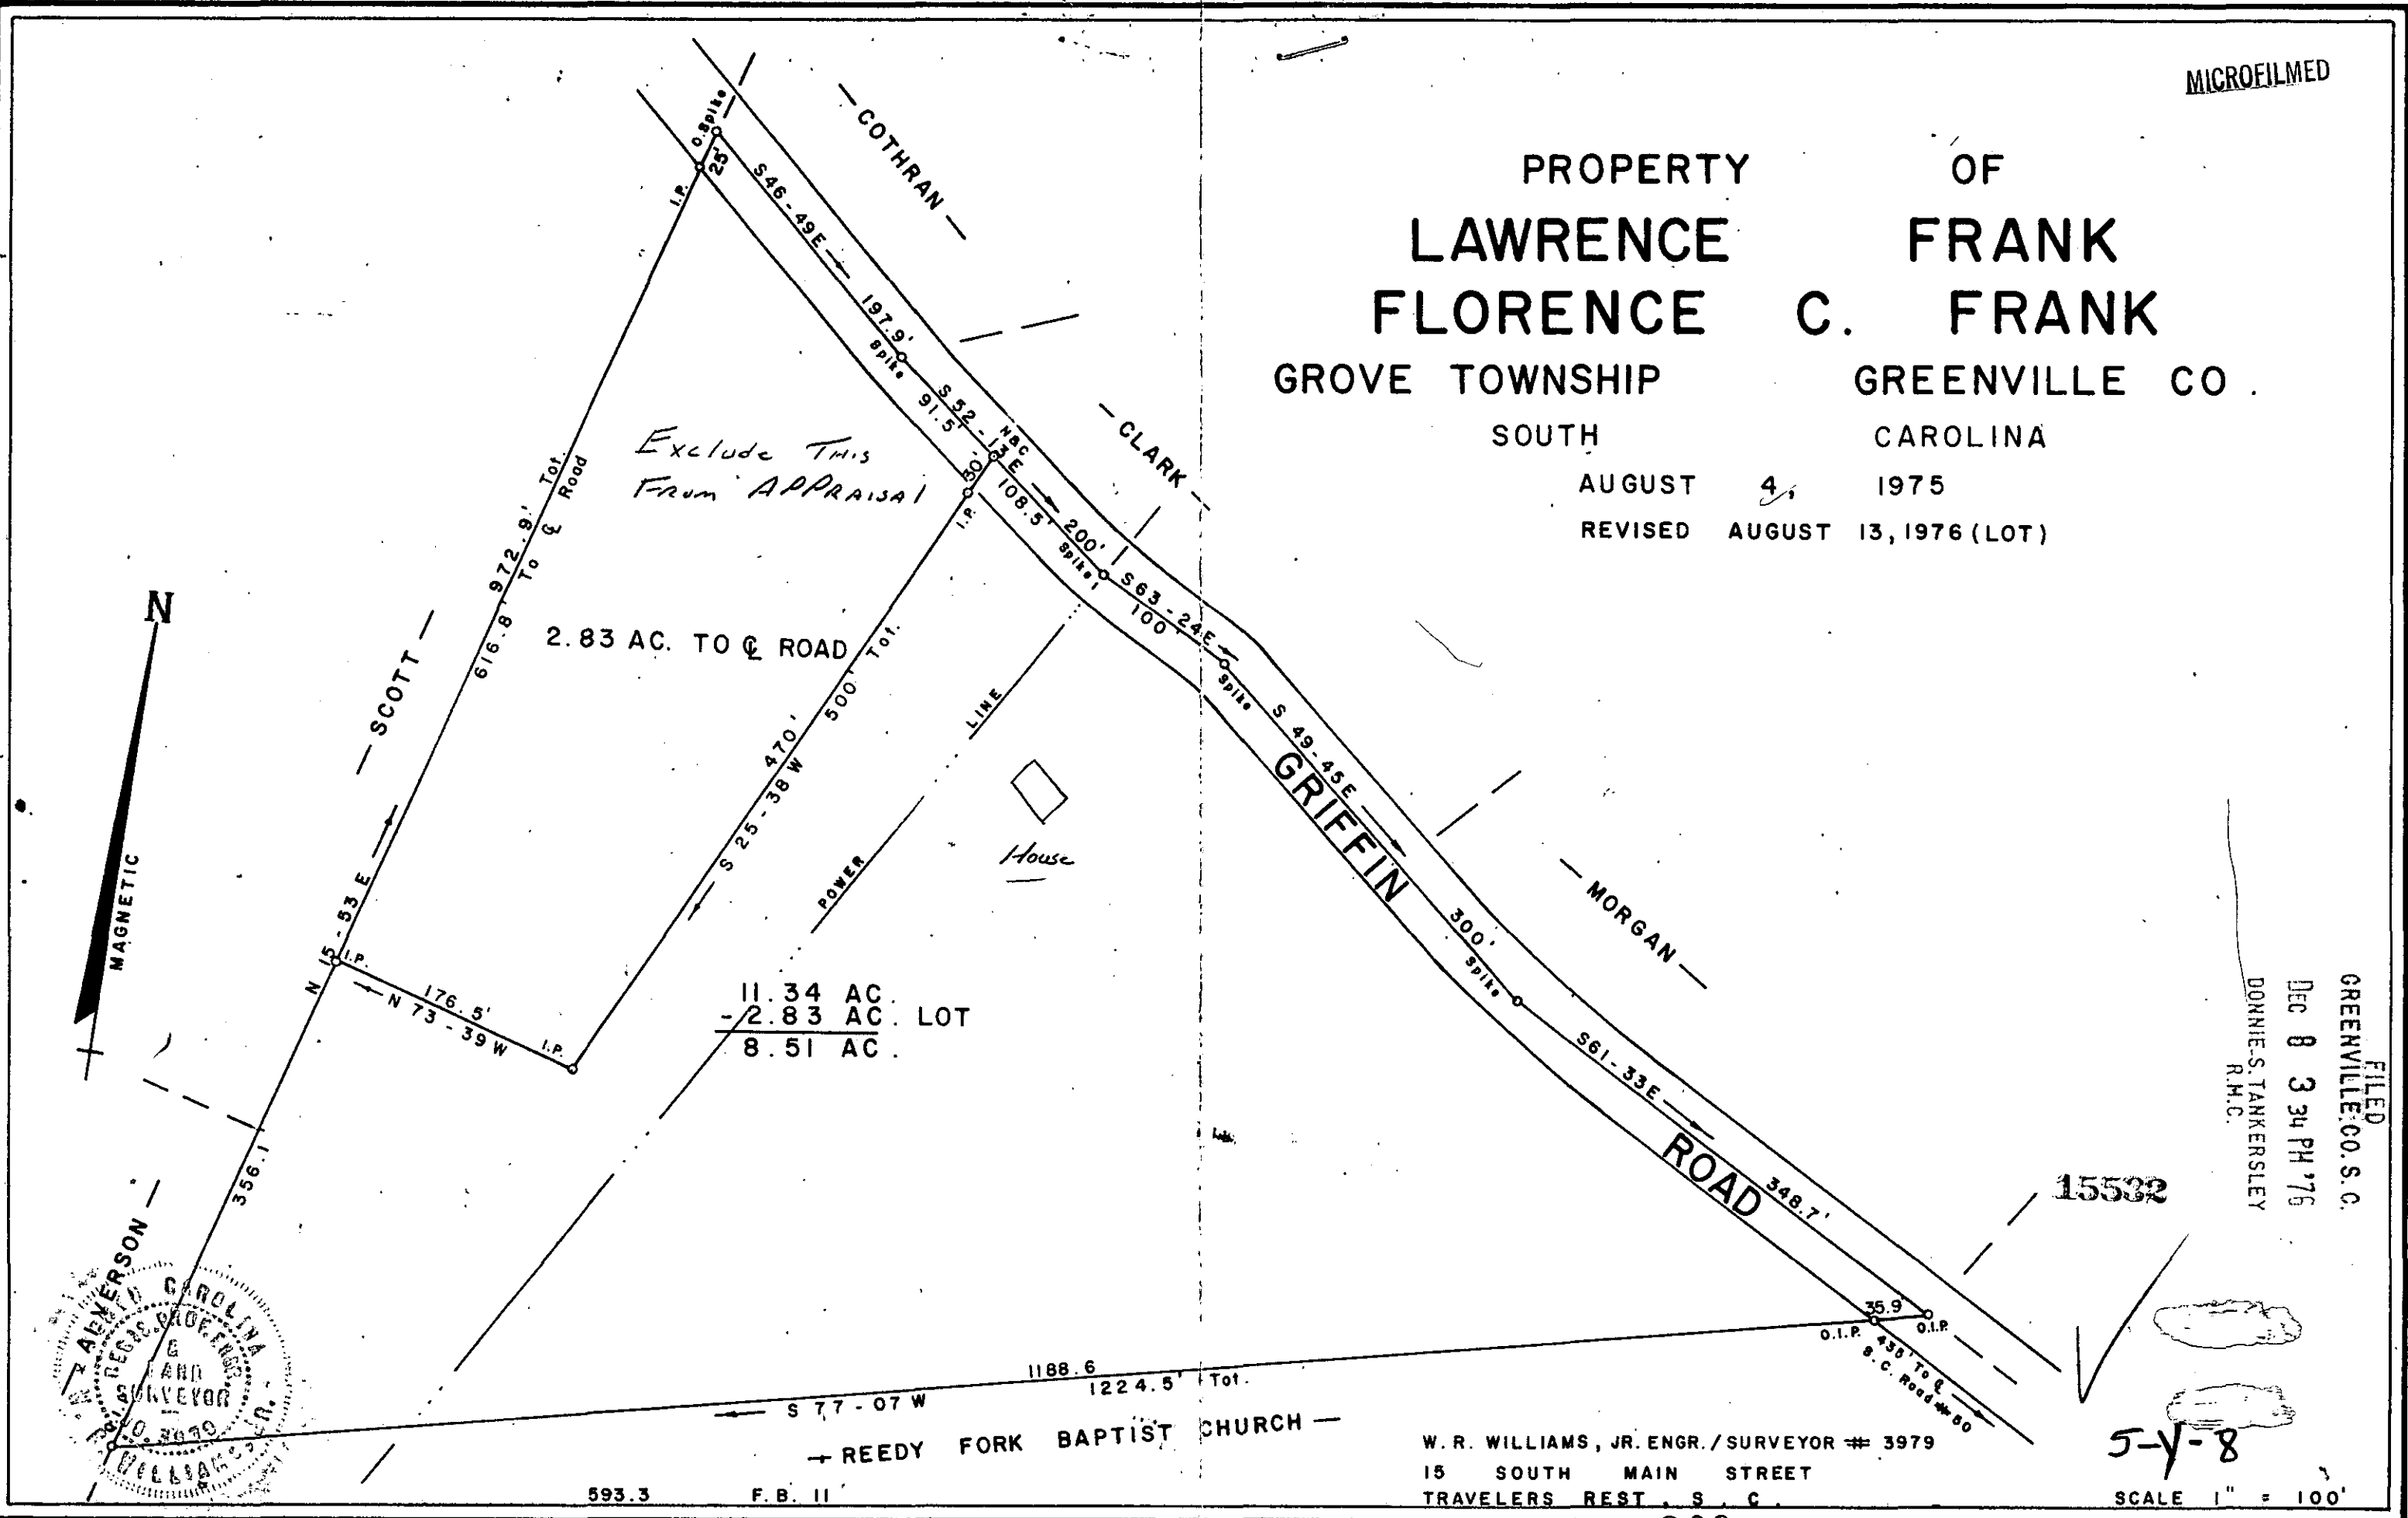


Exclude This From APPRAISAL

2.83 AC. TO Q ROAD

11.34 AC.
- 2.83 AC. LOT
8.51 AC.

House

15532

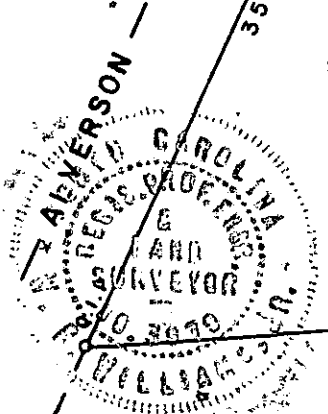

FILED
GREENVILLE CO. S.C.
DEC 8 3 34 PM '76
DONNIE S. TANKERSLEY
R.M.C.

W. R. WILLIAMS, JR. ENGR. / SURVEYOR # 3979
15 SOUTH MAIN STREET
TRAVELERS REST, S. C.

5-Y-8
SCALE 1" = 100'

1075